

Yalobusha
VB 2000
4-8-76

MISSISSIPPI
 BOARD OF WATER COMMISSIONERS
 416 North State Street
 Jackson, Mississippi 39201

WATER WELL DRILLERS LOG

4-8 date well completed 1976 Lipe well Co. firm name Yalobusha county well located

LANDOWNER:
Me. Dixon
Oakland Miss.
 (mailing address)

WELL LOCATION:
 sec 30 T 26N R 5E
8 miles West of Oakland
 (distance) (direction) (nearest town)

description of formations encountered	from	to
Top soil	0	20
red sand	20	40
" "	40	60
Clay	60	80
" "	80	100
sand	100	134

WELL PURPOSE:
 (home, irrigation, municipal, industrial)

WELL COMPLETION DATA:

(1) diameter (inches) 4

(2) total depth (feet) 134

(3) static water level (feet) 80 below above top of ground.

(4) casing PVC 124
 (material) (depth)

4 If telescope see back.
 (size)

(5) screen 10 124
 (length) (depth to top)

4 PVC
 (size) (material)

(6) pump 3/4 10
 (HP) (yield gpm)

elec.
 (type power)

(7) electric log None
 (yes or no)

None
 (organization running log)

(8) how well bottom plugged PVC
cap


DRILLERS REMARKS:

MAY 1 1976

MISS. RD. OF WATER COMMISSIONERS

If well telescopes please sketch and show depths.

GROUND LEVEL

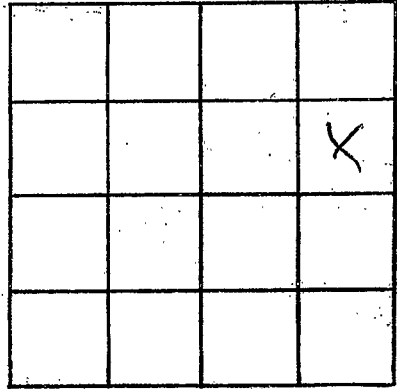

SECTION 30

Please indicate well location X.

ADDITIONAL INFORMATION

If more than one screen,
show locations of each on sketch.