

YALOBUSHA
B
1-23-76

MISSISSIPPI
BOARD OF WATER COMMISSIONERS
416 North State Street
Jackson, Mississippi 39201

WATER WELL DRILLERS LOG

1-23 1976 Life Well Co. Yalobusha
date well completed firm name county well located


LANDOWNER:
Bacel Kelly
Water Valley Miss.
(mailing address)

description of formations encountered	from to	
	ft	ft
<u>Top soil</u>	<u>0</u>	<u>20</u>
<u>red sand</u>	<u>20</u>	<u>40</u>
<u>white sand</u>	<u>40</u>	<u>60</u>
<u>l r l l</u>	<u>60</u>	<u>100</u>
<u>blue clay</u>	<u>100</u>	<u>120</u>
<u>l l l</u>	<u>120</u>	<u>140</u>
<u>sand</u>	<u>140</u>	<u>160</u>
<u>l l</u>	<u>160</u>	<u>180</u>
<u>l l</u>	<u>180</u>	<u>200</u>
<u>l l</u>	<u>200</u>	<u>224</u>

WELL LOCATION:
sec 22 T 11 N R 5 E
5 miles SW of Water Valley
(distance) (direction) (nearest town)

WELL PURPOSE:
(home) irrigation, municipal, industrial

- WELL COMPLETION DATA:
- (1) diameter (inches) 4
 - (2) total depth (feet) 224
 - (3) static water level (feet) 80 below above top of ground.
 - (4) casing PVC, 214,
(material) (depth)
4 If telescope see back.
(size)
 - (5) screen 10, 214,
(length) (depth to top)
4, PVC
(size) (material)
 - (6) pump 3/4, 10,
(HP) (yield gpm)
elec.
(type power)
 - (7) electric log no,
(yes or no)
no
(organization running log)
 - (8) how well bottom plugged PVC
plug

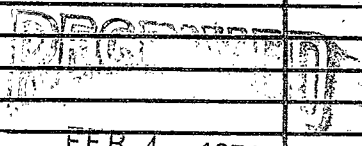


FEB 4 1976

DRILLERS REMARKS:

MISS. BD. OF WATER COMM

If well telescopes please sketch and show depths.

GROUND LEVEL

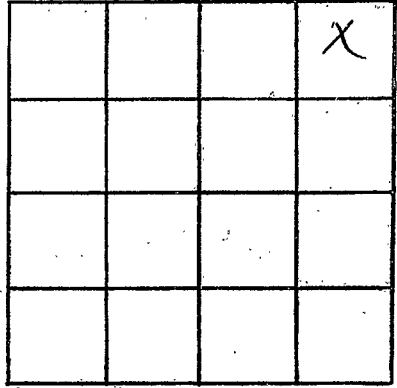

SECTION 22

Please indicate well location X.

ADDITIONAL INFORMATION

If more than one screen, show locations of each on sketch.