

YALOBUSHA
B 2000
10-16-76

MISSISSIPPI
 BOARD OF WATER COMMISSIONERS
 416 North State Street
 15F Jackson, Mississippi 39201

WATER WELL DRILLERS LOG

10-16 date well completed 1976 Live Well Co. firm name Yalobusha county well located

LANDOWNER:
D.R. McMillen
Water Valley MS.
 (mailing address)

description of formations encountered	from	to
TOP Soil	0	20
sand	20	40
ll	40	80
Clay	80	100
sand	100	143

WELL LOCATION:
 sec. 7 T. 11N R. 5E
6 miles West of Water Valley
 (distance) (direction) (nearest town)

WELL PURPOSE:
 (home, irrigation, municipal, industrial)

WELL COMPLETION DATA:

(1) diameter (inches) 4

(2) total depth (feet) 143

(3) static water level (feet) 30 below above top of ground.

(4) casing PVC 133
 (material) (depth)
4 If telescope see back.
 (size)

(5) screen 10 133
 (length) (depth to top)
4 PVC
 (size) (material)

(6) pump 2 20
 (HP) (yield gpm)
elec.
 (type power)

(7) electric log no
 (yes or no)
no
 (organization running log)

(8) how well bottom plugged PVC
CAP

RECEIVED


OCT 26 1976

DRILLERS REMARKS:

MISS. BD. OF WATER COMMISSIONERS

If well telescopes please sketch and show depths.

GROUND LEVEL

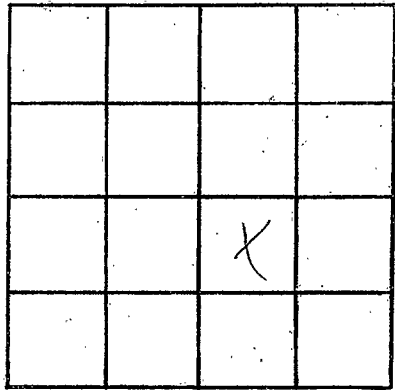

SECTION 2

Please indicate well location X.

ADDITIONAL INFORMATION

If more than one screen,
show locations of each on sketch.