

YALOBUSHA
1B 2003
2-17-77

MISSISSIPPI
 BOARD OF WATER COMMISSIONERS
 416 North State Street
 Jackson, Mississippi 39201

WATER WELL DRILLERS LOG

Yalobusha

2/17/77 19 North Mississippi Well Drill Yalobusha
 date well completed firm name county/well located


LANDOWNER: <u>Mable Holmes</u> <u>Rt. 2</u>	description of formations encountered	from	to
<u>Water Valley Miss</u> (mailing address)	<u>Clay</u> <u>Sand</u> <u>Water Sand</u>	<u>0'</u>	<u>10'</u> <u>80'</u> <u>100'</u>
WELL LOCATION: sec. <u>13</u> T. <u>11</u> N. R. <u>5</u> E. <u>3</u> miles <u>West</u> of <u>Water Valley</u> (distance) (direction) (nearest town)			
WELL PURPOSE: <u>home</u> (home, irrigation, municipal, industrial)			
WELL COMPLETION DATA:			
(1) diameter (inches) <u>4"</u>			
(2) total depth (feet) <u>100"</u>			
(3) static water level (feet) <u>70</u> below/above top of ground.			
(4) casing <u>Plastic</u> (material) <u>100"</u> (depth)			
(size) if telescope see back.			
(5) screen <u>10"</u> (length) <u>100</u> (depth to top)			
(size) <u>Plastic</u> (material)			
(6) pump <u>1/2</u> (HP) <u>10</u> (yield gpm)			
<u>Elect</u> (type power)			
(7) electric log <u>NO</u> (yes or no)			
(organization running log)			
(8) how well bottom plugged <u>Wash Bottom</u>			
DRILLERS REMARKS:			

RECEIVED
 MAR 21 1977

MISS. BD. OF WATER COMM.

If well telescopes please
sketch and show depths.

GROUND LEVEL

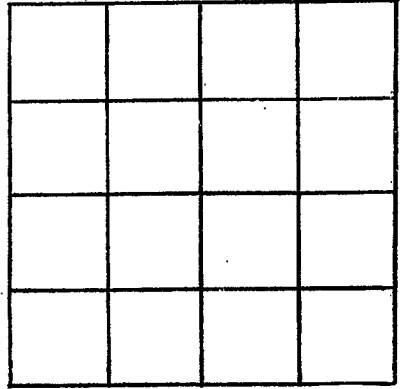

SECTION _____

Please indicate well location X.

ADDITIONAL INFORMATION

If more than one screen,
show locations of each on sketch.