

MISSISSIPPI DEPARTMENT OF NATURAL RESOURCES

Bureau of Land and Water Resources

Southport Mall

P.O. Box 10631

Jackson, Mississippi 39209

WATER WELL DRILLERS LOG

YARBUSH  
Bozoo

5-29 1991 Lipe Well Supply Yalobusha  
date well completed firm name county well located

LANDOWNER: Tommy Reynolds  
P.O. Drawer 220  
Charleston, ms 38921  
(mailing address)


WELL LOCATION:  
sec. 7 T. 10 N. R. 5 E.  
5 miles W of Water Valley  
(distance) (direction) (nearest town)

WELL PURPOSE:  
(home, irrigation, municipal, industrial)

WELL COMPLETION DATA:

- (1) diameter (inches) 4
- (2) total depth (feet) 140
- (3) static water level (feet) \_\_\_\_\_ below/above top of ground.
- (4) casing Pvc, 130  
(material) (depth)  
4 if telescope see back.  
(size)
- (5) screen 10', 130  
(length) (depth to top)  
4, Pvc  
(size) (material)
- (6) pump 1 \_\_\_\_\_  
(HP) (yield gpm)  
(type power)
- (7) electric log \_\_\_\_\_  
(yes or/no)  
(organization running log)
- (8) how well bottom plugged Capped

description of formations encountered	from	to
topsoil - sand	0	20
Sand	20	31
Clay	31	40
Clay Sand mix	40	60
" "	60	80
Sand	80	100
Sand	100	120
Sand	120	140

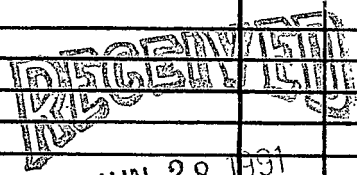


Dept. of Environmental Quality  
Bureau of Land & Water Resources

DRILLERS REMARKS:

If well telescopes please sketch and show depths.

GROUND LEVEL

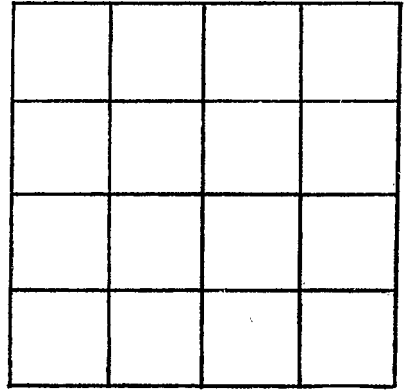

SECTION \_\_\_\_\_

Please indicate well location X.

ADDITIONAL INFORMATION

If more than one screen,  
show locations of each on sketch.