

Yalobusha
 CT
 4-67

MISSISSIPPI
 BOARD OF WATER COMMISSIONERS
 416 North State Street
 Jackson, Mississippi 39201

CODED

CODED

WATER WELL DRILLERS LOG

4-6 date well completed 1967 Robinson + Son firm name Yalobusha county well located

LANDOWNER: Jessie Woodall

description of formations encountered

from to

Plot 1

sand + clay 0 20
white sand + clay 20 80
white sand 80 95

Water Valley, Miss
 (mailing address)

WELL LOCATION:

sec. 29 T. 10 N. R. 4 E
4 miles NW of Water Valley
 (distance) (direction) (nearest town)

WELL PURPOSE:


(home, irrigation, municipal, industrial)

WELL COMPLETION DATA:

- (1) diameter (inches) 2 in
- (2) total depth (feet) 95
- (3) static water level (feet) 30 below above top of ground.
- (4) casing Plastic, 90 (material) (depth)
2 in (size) if telescope see back.
- (5) screen 5 ft, 90 (length) (depth to top)
3 in, gravel packed (size) (material)
- (6) pump 1 HP, 10 (HP) (yield gpm)
TKA 220 (type power)
- (7) electric log no (yes or no)
 (organization running log)
- (8) how well bottom plugged Capped

DRILLERS REMARKS:

Plastic Water Well

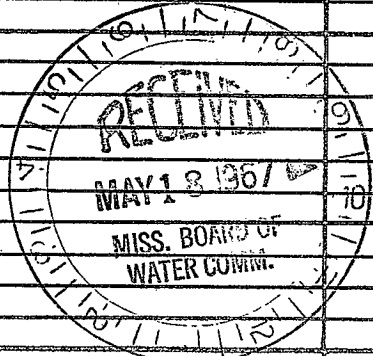

If well telescopes please sketch and show depths.

GROUND LEVEL

		X	

SECTION 29

Please indicate well location X.

ADDITIONAL INFORMATION

If more than one screen, show locations of each on sketch.