

YALOBAMA  
 MISSISSIPPI BOARD OF WATER COMMISSIONERS  
 C10  
 3-8-61

MISSISSIPPI BOARD OF WATER COMMISSIONERS  
 WATER WELL DRILLERS LOG

2 CODED  
 CODED

Date: 3/8, 1961, Driller: Elliott Hardwick County, Lafayette  
 (Name)

(1) Owner of Land: Camp Ground Baptist Church  
 (Name)  
 Water Valley, Miss - Rt 1  
 (Address)  
 3621-4  
 (2) Location: 1/4, 3/4, Sec. 1, T. 12 N., R. 10 E., S. 1  
 1 miles West of Water Valley  
 (distance) (direction) (Nearest Town)  
 (3) Topography: Hilly  
 (Hilly) (Flat) (Level)  
 (4) Purpose of Well: Domestic  
 (Domestic Irrigation, Municipal, Industrial, Other)


Description & Color of Materials Sand, Clay, Red Clay, Shell, etc.	Thick- ness Feet	Depth Feet
Red Clay	12	12
Sand - & Clay	114	126
Clay - white	2	128
Sand -	40	168
Clay - Pink -	1	169

Information upon completion of well:

(1) Diameter: 2 inches.  
 (2) Total Depth: 168 feet.  
 (3) Water Level: 135 feet below top of ground.  
 (4) Cased to: 1/2, Size: 1/2  
 (5) Screen: Size: 2", Length: 6'  
 (6) Were any formations sealed against pollution?  
 yes, no.  no.

If YES depth of formation \_\_\_\_\_  
 Why \_\_\_\_\_

Drillers Remarks: \_\_\_\_\_

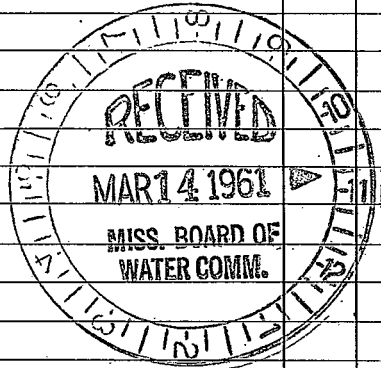

(Use Back Side)

Well No.

