

Yalobosha

C 11

10-66

MISSISSIPPI BOARD OF WATER COMMISSIONERS

CODED
CODED

WATER WELL DRILLERS LOG

Date: Oct. 19, 1966, Driller: Jerry Roberson County Yalobosha
(When well drilled) (Name) (Where well is located)

(1) Owner of Land: <u>William Dickey</u> (Name)	Description & Color of Materials Sand, Clay, Red Clay, Shell, etc.	Thick- ness Feet	Depth Feet
<u>Rt. 1, Water Valley, Miss.</u> (Address)	<u>Sand + Clay</u>	<u>20</u>	<u>20</u>
(2) Location: <u>NE 1/4, SE 1/4, Sec. 30 T10R4</u>	<u>Sand + white Clay</u>	<u>20</u>	<u>40</u>
<u>4 1/2</u> miles <u>NW</u> , of <u>Water Valley</u> (distance) (direction) (Nearest Town)	<u>Sand</u>	<u>60</u>	<u>100</u>
(3) Topography: <input checked="" type="checkbox"/> (Hilly) <input type="checkbox"/> (Flat) <input type="checkbox"/> (Level)			
(4) Purpose of Well: <u>Home</u> (Domestic Irrigation Municipal, Industrial, Other)			

Information upon completion of well:

(1) Diameter 2 inches.

(2) Total Depth 100 feet.

(3) Water Level 60 feet below top of ground.


(4) Cased to 95, Size 2 in.

(5) Screen: Size 3 in., Length 5 ft.

(6) Were any formations sealed against pollution?
 yes, no.

If YES depth of formation _____
Why _____

Drillers Remarks: Plastic Water Well
Yield in gpm: 6
Size pump: 1 H.P. Jet Pump
Type power: 110 - T.V.A.

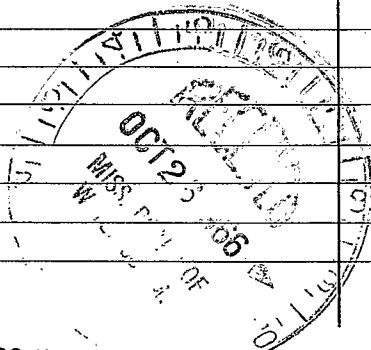

[The page contains extremely faint and illegible text, likely bleed-through from the reverse side of the document. No specific words or phrases can be discerned.]