

YALOBUSHA  
 C13  
 2-25-75

MISSISSIPPI  
 BOARD OF WATER COMMISSIONERS  
 416 North State Street  
 Jackson, Mississippi 39201

CODED

WATER WELL DRILLERS LOG


Feb 75 1975 Nelson Cain Yalobusha  
 date well completed firm name county well located

LANDOWNER: <u>OK, S, Lewis</u> <u>Water Valley</u>	description of formations encountered	from	to
(mailing address)	<u>Clay Sand Strata</u>	<u>0</u>	<u>60</u>
WELL LOCATION: sec. <u>36</u> T <u>11</u> N R <u>4</u> E <u>6</u> miles <u>S-E</u> of <u>Water Valley</u> (distance) (direction) (nearest town)	<u>band</u>	<u>60</u>	<u>120</u>
WELL PURPOSE: <u>Home</u> (home, irrigation, municipal, industrial)	CODED		
WELL COMPLETION DATA: (1) diameter (inches) <u>4"</u> (2) total depth (feet) <u>120</u> (3) static water level (feet) <u>85</u> below above top of ground. (4) casing <u>Plastic</u> , <u>120</u> , (material) (depth) (size) If telescope see back. (5) screen <u>10'</u> , <u>110</u> (length) (depth to top) <u>4"</u> , <u>Plastic</u> (size) (material) (6) pump <u>3/4</u> , <u>10</u> (HP) (yield gpm) <u>Electric</u> (type power) (7) electric log <u>No</u> (yes or no) (organization running log) (8) how well bottom plugged <u>With Bot</u>			
DRILLERS REMARKS:	MAR 31 1975		

MISS. BD. OF WATER COMMISSIONERS

If well telescopes please sketch and show depths.

GROUND LEVEL

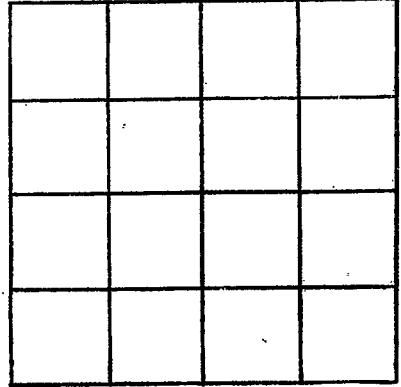

SECTION \_\_\_\_\_

Please indicate well location X.

ADDITIONAL INFORMATION

If more than one screen, show locations of each on sketch.