

YAL0.
C 14
11-6-64

MISSISSIPPI BOARD OF WATER COMMISSIONERS

INDEXED
INDEXED

WATER WELL DRILLERS LOG

Date: 11-6, 1964, Driller: J B Cain County Panola

(Name)


(1) Owner of Land	Description & Color of Materials Sand, Clay, Red Clay, Shell, etc.	Thick- ness Feet	Depth Feet
<u>Phelia Fly</u> (Name) <u>Water Valley Miss</u> (Address)	<u>Clay</u>	<u>0</u>	<u>30</u>
<u>6</u> miles <u>SE</u> of <u>Water Valley</u> (distance) (direction) (Nearest Town)	<u>Sand</u>	<u>30</u>	<u>60</u>
(2) Location: $\frac{1}{4}$, <u>22</u> , $\frac{1}{4}$, Sec. <u>17</u> , T. <u>4</u> , R. <u>4</u>			
(3) Topography: <u>Level</u> (Hilly) (Flat) (Level)			
(4) Purpose of Well: <u>Home</u> (Domestic Irrigation Municipal, Industrial, Other)			

Information upon completion of well:

- (1) Diameter 2 inches.
- (2) Total Depth 60 feet.
- (3) Water Level 48 feet below top of ground.
- (4) Cased to 60, Size 2"
- (5) Screen: Size 1/4, Length 5 FT.
Plastic
- (6) Were any formations sealed against pollution?
_____ yes, _____ no.

If YES depth of formation _____
Why _____

Drillers Remarks: _____

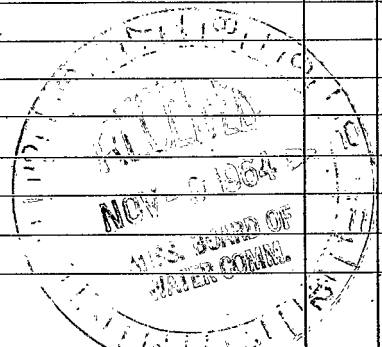

(Use Back-Side)

Well No.

