

YAL0,

MISSISSIPPI BOARD OF WATER COMMISSIONERS

CODED

8-1-64

WATER WELL DRILLERS LOG

Date: 8-1, 1964, Driller: J B Cain, County: Panola

(1) Owner of Land: M Fortenberry, (Name)
Water Valley, (Address)

Description & Color of Materials
Sand, Clay, Red Clay, Shell, etc.

Thick-ness Feet

Depth Feet

0 60
60 75

(2) Location: 26 1/4, Sec. 10, T7R
3 miles W of Water Valley

(3) Topography: (Hilly) (Flat) (Level)

(4) Purpose of Well: Home
(Domestic Irrigation, Municipal, Industrial, Other)

Information upon completion of well:

(1) Diameter: 4 inches.

(2) Total Depth: 75 feet.

(3) Water Level: 20 feet below top of ground.

(4) Cased to: 75, Size: 8 1/4


(5) Screen: Size: 4, Length: 8 FT

(6) Were any formations sealed against pollution?
yes, no.

If YES depth of formation

Why

Drillers Remarks:

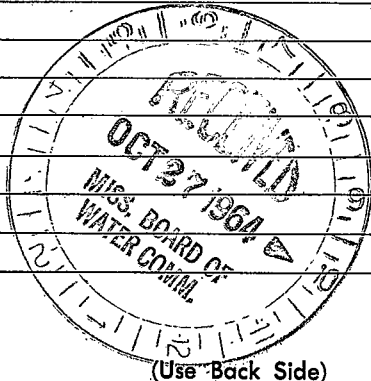

Well No.

