

Yalobusha
C23
8-67

MISSISSIPPI
BOARD OF WATER COMMISSIONERS
416 North State Street
Jackson, Mississippi 39201

CODED
CODED

WATER WELL DRILLERS LOG

Aug 24 1967 Roberson & Son Yalobusha
date well completed firm name county well located

LANDOWNER: Charles Goodman

description of formations encountered	from	to

Water Valley, Miss
(mailing address)

<u>Sand + Clay</u>	<u>0</u>	<u>40</u>
<u>Sand</u>	<u>40</u>	<u>60</u>
<u>Sand + White Clay</u>	<u>60</u>	<u>120</u>
<u>Sand</u>	<u>120</u>	<u>170</u>

WELL LOCATION:
sec. 3 T 11 N R 4 E
2 1/4 miles S of W.V.
(distance) (direction) (nearest town)


WELL PURPOSE: Home
(home, irrigation, municipal, industrial)

WELL COMPLETION DATA:

- (1) diameter (inches) 4"
- (2) total depth (feet) 170
- (3) static water level (feet) 152 below top of ground.
- (4) casing plastic, 165,
(material) (depth)
4"
(size) If telescope see back.
- (5) screen 5 ft, 165
(length) (depth to top)
6", gravel
(size) (material)
- (6) pump 34 12
(HP) (yield gpm)
220
(type power)
- (7) electric log no
(yes or no)


(organization running log)
- (8) how well bottom plugged Capped

DRILLERS REMARKS: Plastic
Water Well

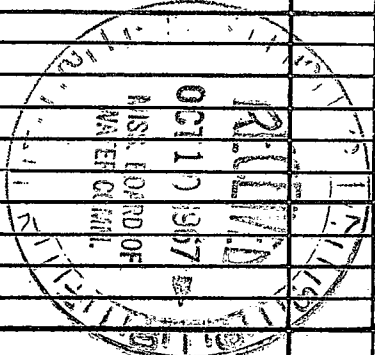

If well telescopes please sketch and show depths.

GROUND LEVEL

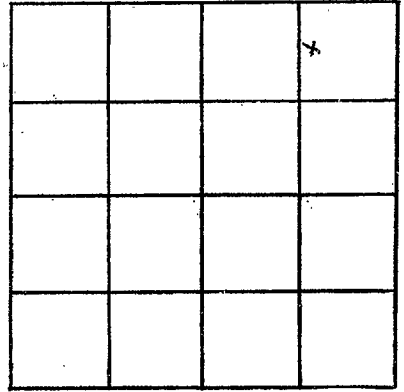

SECTION 3

Please indicate well location X.

ADDITIONAL INFORMATION

If more than one screen,
show locations of each on sketch.