

YALOW.

MISSISSIPPI BOARD OF WATER COMMISSIONERS

~~100~~ C2A
4-10-65

WATER WELL DRILLERS LOG

CODED

CODED

Date: 4-10, 1965, Driller: J B Cain County Panola
(Name)

(1) Owner of Land: Mrs Loforth
(Name)
Water Valley Miss
(Address)

Description & Color of Materials
Sand, Clay, Red Clay, Shell, etc.
Top of Sand
Thickness Feet
0 20
20 75
Depth Feet

(2) Location: 1/4, 3/4, Sec. 17 R 4
8 miles E of Water Valley
(distance) (direction) (Nearest Town)

(3) Topography: Flat
(Hilly) (Flat) (Level)

(4) Purpose of Well: Home
(Domestic Irrigation
Municipal, Industrial, Other)

Information upon completion of well:

(1) Diameter 2 inches.

(2) Total Depth 75 feet.

(3) Water Level 60 feet below top of ground.

(4) Cased to 75, Size 2"


(5) Screen: Size 3", Length 5
Gravel Screen

(6) Were any formations sealed against pollution?
_____ yes, _____ no.

If YES depth of formation _____

Why _____

Drillers Remarks: _____

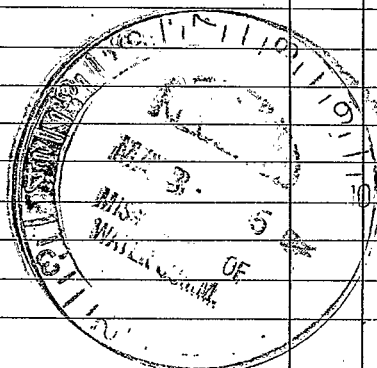

Well No.

(Use Back Side)

