

4-11-65 C 25

WATER WELL DRILLERS LOG

CODED
CODED

Date: 4-11, 1965, Driller: J B Cain County Panola (Name)

(1) Owner of Land	Description & Color of Materials Sand, Clay, Red Clay, Shell, etc.	Thick- ness Feet	Depth Feet
Mrs Goforth (Name) Water Valley Miss Land (Address)	Bro Clay	0	43
(2) Location: 1/4, 1/4, Sec. T 35 R 11 E 8 miles (distance) NE of Water Valley (Nearest Town)			45 110
(3) Topography: (Hilly) (Flat) (Level)			
(4) Purpose of Well: (Domestic Irrigation Municipal, Industrial, Other)			

Information upon completion of well:

(1) Diameter 2 inches.

(2) Total Depth 110 feet.

(3) Water Level 80 feet below top of ground.


(4) Cased to 110, Size

(5) Screen: Size 3, Length 5
Shallow Screen

(6) Were any formations sealed against pollution?
_____ yes, _____ no.

If YES depth of formation _____
Why _____

Drillers Remarks: _____

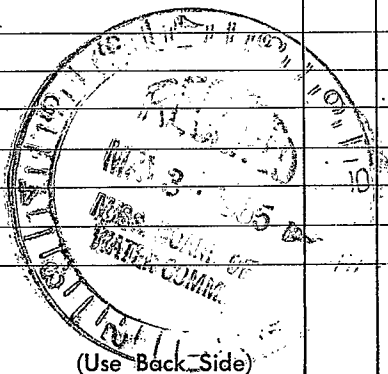

Well No.

