

**MISSISSIPPI  
BOARD OF WATER COMMISSIONERS**  
416 North State Street  
Jackson, Mississippi 39201

CODED  
CODED

**WATER WELL DRILLERS LOG**

Aug 20 1967 Potterson & Son Yalobusha  
date well completed firm name county well located

LANDOWNER: Dalemy Green


description of formations encountered	from	to
<u>sand &amp; Red Clay</u>	<u>0</u>	<u>40</u>
<u>sand &amp; blue clay</u>	<u>40</u>	<u>80</u>
<u>White sand</u>	<u>80</u>	<u>115</u>

Water Valley, Miss  
(mailing address)

WELL LOCATION:  
sec 34 T 10 N R 4 E  
S W  
(?) 6 miles NE of W. V.  
(distance) (direction) (nearest town)

WELL PURPOSE: Domestic  
(home, irrigation, municipal, industrial)

- WELL COMPLETION DATA:
- (1) diameter (inches) 4"
  - (2) total depth (feet) 115
  - (3) static water level (feet) 76 below above top of ground.
  - (4) casing plastic 110  
(material) (depth)  
4"  
(size) if telescope see back.
  - (5) screen 5 ft 110  
(length) (depth to top)  
6" gravel packed  
(size) (material)
  - (6) pump 1/2 220  
(HP) (yield gpm)  
(type power)
  - (7) electric log no  
(yes or no)  
  
(organization running log)
  - (8) how well bottom plugged Capped

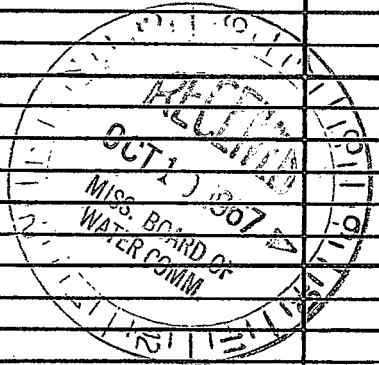

DRILLERS REMARKS: Plastic  
water well

If well telescopes please sketch and show depths.

GROUND LEVEL

			X

SECTION 24

Please indicate well location X.

ADDITIONAL INFORMATION

If more than one screen,  
show locations of each on sketch.