

Yalobusha  
C27  
4-67

MISSISSIPPI  
BOARD OF WATER COMMISSIONERS  
416 North State Street  
Jackson, Mississippi 39201  
WATER WELL DRILLERS LOG

CODED  
CODED

4-4 1967 Roberson & Son Yalobusha  
date well completed firm name county well located

LANDOWNER: Leonard Driggs


description of formations encountered	from to	
	ft	ft
Red clay + sand	0	20
Sand + white clay	20	80
blue clay	80	100
white sand	100	140

PT 1  
Water Valley, Miss.  
(mailing address)

WELL LOCATION:  
sec. 3 T 10 N R 4 E  
S W  
2 1/2 miles NW of Water Valley  
(distance) (direction) (nearest town)

WELL PURPOSE: Home  
(home, irrigation, municipal, industrial)

- WELL COMPLETION DATA:
- (1) diameter (inches) 2 in
  - (2) total depth (feet) 140
  - (3) static water level (feet) 86 below top of ground.
  - (4) casing Plastic, 135 (material) (depth)  
2 in (size) if telescope see back.
  - (5) screen 5 ft, 135 (length) (depth to top)  
3 in, Gravel packed (size) (material)
  - (6) pump 1 HP, 7 (HP) (yield gpm)  
1/4 110 (type power)
  - (7) electric log no (yes or no)
  - (organization running log)
  - (8) how well bottom plugged capped

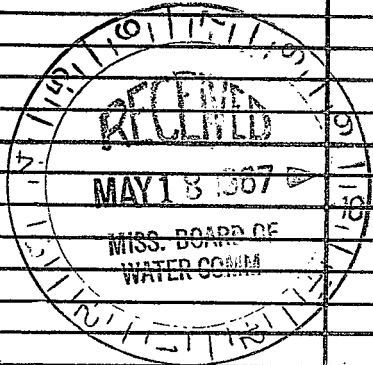

DRILLERS REMARKS: Plastic Water Well

If well telescopes please sketch and show depths.

GROUND LEVEL

		X	

SECTION 32

Please indicate well location X.

ADDITIONAL INFORMATION

If more than one screen, show locations of each on sketch.