

MISSISSIPPI  
 BOARD OF WATER COMMISSIONERS  
 416 North State Street  
 Jackson, Mississippi 39201

CODED  
 CODED

WATER WELL DRILLERS LOG

*Yalobusha*  
*C 28*  
*9-67*

*Sept 20* 19*67* *Roberson & Son* *Yalobusha*  
 date well completed firm name county well located

LANDOWNER: *Gilley Johnston*  
*Water Valley, Miss*  
 (mailing address)


description of formations encountered	from	to
<i>White Clay + sand</i>	<i>0</i>	<i>9.0</i>
<i>Blue Clay + sand</i>	<i>9.0</i>	<i>40</i>
<i>White Clay + sand</i>	<i>40</i>	<i>80</i>
<i>White sand</i>	<i>80</i>	<i>120</i>

WELL LOCATION: *30-10-4*  
 sec. *32* T. *10* N. R. *4* E  
*3* miles *1/4 W* of *W.V.*  
 (distance) (direction) (nearest town)

WELL PURPOSE: *home*  
 (home, irrigation, municipal, industrial)

- WELL COMPLETION DATA:
- (1) diameter (inches) *2"*
  - (2) total depth (feet) *120*
  - (3) static water level (feet) *90* below above top of ground.
  - (4) casing *plastic*, *115'*,  
 (material) (depth)  
*2"* if telescope see back.  
 (size)
  - (5) screen *5 ft*, *115'*  
 (length) (depth to top)  
*3"*, *gravel packed*  
 (size) (material)
  - (6) pump *1* *5*  
 (HP) (yield gpm)  
*110*  
 (type power)
  - (7) electric log *no*  
 (yes or no)  
 (organization running log)
  - (8) how well bottom plugged *Capped*

DRILLERS REMARKS: *plastic*  
*Water well*

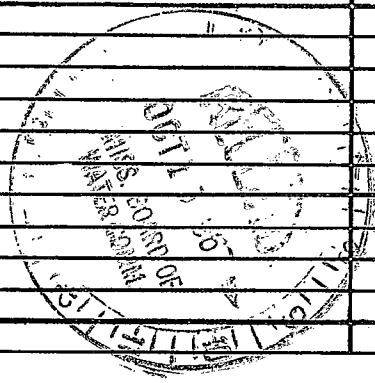

If well telescopes please sketch and show depths.

GROUND LEVEL

		X	

SECTION 32

Please indicate well location X.

ADDITIONAL INFORMATION

If more than one screen,  
show locations of each on sketch.