

CODED
CODED

MISSISSIPPI
BOARD OF WATER COMMISSIONERS
416 North State Street
Jackson, Mississippi 39201

WATER WELL DRILLERS LOG

Yalobusha
C 29
6-67

6-27 date well completed W. S. Lubersack Sons firm name Yalobusha county well located

LANDOWNER: M. H. Santrip


| description of formations encountered | from | to |
|---------------------------------------|-----------|------------|
| <u>sandy clay</u> | <u>0</u> | <u>150</u> |
| <u>W. P. L. sand</u> | <u>60</u> | <u>100</u> |

Water Valley, Miss
(mailing address)

WELL LOCATION:
sec. 29 T. 10 N R. 4 E
S W
4 miles NW of Water Valley
(distance) (direction) (nearest town)

WELL PURPOSE: Home
(home, irrigation, municipal, industrial)

- WELL COMPLETION DATA:
- (1) diameter (inches) 2 in
 - (2) total depth (feet) 100
 - (3) static water level (feet) 50 below above top of ground.
 - (4) casing plastic, 95,
(material) (depth)
2 in if telescope see back.
(size)
 - (5) screen 5 ft, 95
(length) (depth to top)
3 in, gravel packed
(size) (material)
 - (6) pump 1 HP 8
(HP) (yield gpm)
2-VA-110
(type power)
 - (7) electric log no
(yes or no)
no
(organization running log)
 - (8) how well bottom plugged Capped

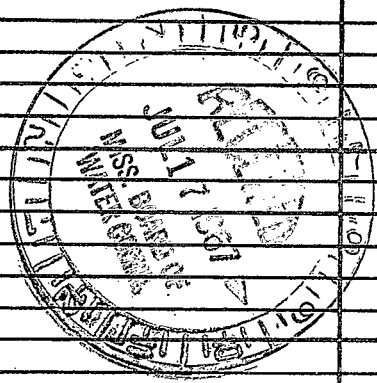

DRILLERS REMARKS: Plastic Well

If well telescopes please sketch and show depths.

GROUND LEVEL

| | | | |
|--|--|---|--|
| | | f | |
| | | | |
| | | | |
| | | | |

SECTION 29

Please indicate well location X.

ADDITIONAL INFORMATION

If more than one screen, show locations of each on sketch.