

ISF

INDEXED

INDEXED

INDEXED

Yalobusha
C 30
9-20-68

MISSISSIPPI
BOARD OF WATER COMMISSIONERS
416 North State Street
Jackson, Mississippi 39201

WATER WELL DRILLERS LOG

Yalobusha
county well located

9-20-1968 Layne-Central Co.
date well completed firm name

LANDOWNER: City of Water
Valley, Mississippi

description of formations encountered	from	to
Clay	0	9
Coarse Sand	9	73
Clay	73	82

(mailing address)

WELL LOCATION: NW 1/4 NW 1/4
sec. 8 T. 11 N. R. 4 E
(S) (W)

_____ miles _____ of _____
(distance) (direction) (nearest town)


WELL PURPOSE: municipal
(home, irrigation, municipal, industrial)

WELL COMPLETION DATA:

- (1) diameter (inches) 12"
- (2) total depth (feet) 74'
- (3) static water level (feet) 15' 7" ^{below} ~~XXXX~~
top of ground.
- (4) casing steel, 42'
(material) (depth),
12"
(size) if telescope see back.
- (5) screen 30', 44"
(length) (depth to top)
10", s. s. shutter
(size) (material)
- (6) pump 25 800
(HP) (yield gpm)
electric
(type power)
- (7) electric log _____
(yes or no)

(organization running log)
- (8) how well bottom plugged _____

INDEXED

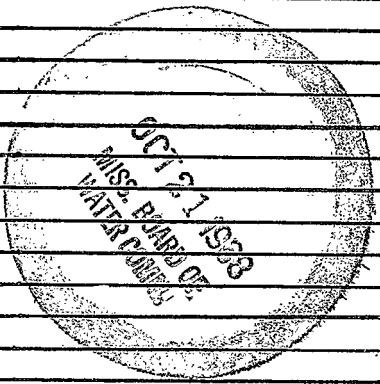

DRILLERS REMARKS:

(F)

If well telescopes please
sketch and show depths.

GROUND LEVEL

SECTION 8

Please indicate well location X.

ADDITIONAL INFORMATION

If more than one screen,
show locations of each on sketch.