

CODED

Yalobusha
C32
5-27-69

MISSISSIPPI
BOARD OF WATER COMMISSIONERS
416 North State Street
Jackson, Mississippi 39201

WATER WELL DRILLERS LOG

May 27 1969 James B. Lipe Yalobusha
date well completed firm name county well located

LANDOWNER: Charlie
SIMPSON
Water Valley Miss.
(mailing address)

description of formations encountered	from	to
Clay	0	20
sand	20	40
"	40	60
"	60	80
sand and clay	80	100
" " "	100	120
Water sand	120	151

WELL LOCATION:
sec. 29 T10 N R4 E
2 miles north of Water Valley
(distance) (direction) (nearest town)

WELL PURPOSE: Home
(home, irrigation, municipal, industrial)


- WELL COMPLETION DATA:
- (1) diameter (inches) 4
 - (2) total depth (feet) 151
 - (3) static water level (feet) 80 below top of ground.
 - (4) casing Plastic, 14B (material) (depth)
If telescope see back. (size)
 - (5) screen 8 14'3" (length) (depth to top)
4 Plastic (size) (material)
 - (6) pump 3/4 10 (HP) (yield gpm)
ELEC. (type power)
 - (7) electric log No (yes or no)
No (organization running log)
 - (8) how well bottom plugged Plastic plug

JUL 9 1969


MISS. BD. OF
WATER COMMISSIONERS

DRILLERS REMARKS:

If well telescopes please sketch and show depths.

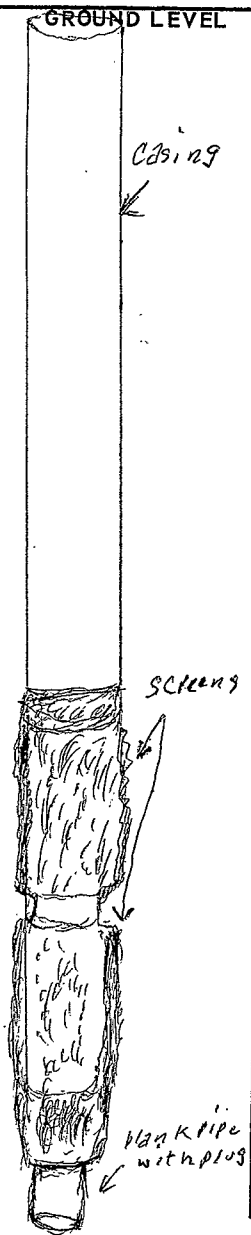

If more than one screen, show locations of each on sketch.

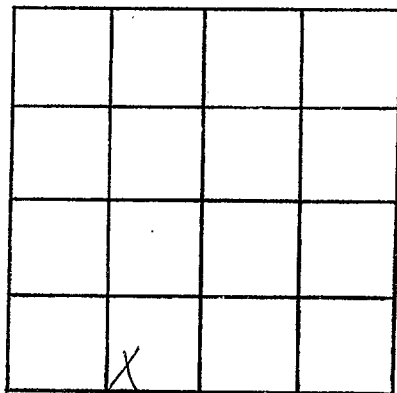

SECTION 29

Please indicate well location X.

ADDITIONAL INFORMATION

Lined area for providing additional information.