

MISSISSIPPI
BOARD OF WATER COMMISSIONERS
416 North State Street
Jackson, Mississippi 39201

CODED

WATER WELL DRILLERS LOG

6-20 1969 SARTAIN Well/Sec 7 Alobusha
 date well completed firm name county well located

LANDOWNER: J. J. CROW

description of formations encountered

from to

WAGNER ST.
WATER Valley, Miss.
(mailing address)

| | | |
|-------------|-----|-----|
| clay | 1' | 4' |
| sand | 4' | 16' |
| Blue clay | 10' | 25' |
| Quartz sand | 25' | 30' |
| Water sand | 30' | 42' |

WELL LOCATION:

sec. 5 T. 11 N. R. 4 E.
 (distance) (direction) (nearest town)
1 miles West of Water Valley

Under Sand
was a deep
white clay

WELL PURPOSE: Home
(home, irrigation, municipal, industrial)

Went 18' in
clay under sand

WELL COMPLETION DATA:

- (1) diameter (inches) 2"
- (2) total depth (feet) 42'
- (3) static water level (feet) 17 below top of ground.
- (4) casing Steel, 37'
(material) (depth)
2" if telescope see back.
(size)
- (5) screen 5' 37'
(length) (depth to top)
1 1/2" S.S. GALZE
(size) (material)
- (6) pump 3/4 5 1/2
(HP) (yield gpm)
Electric
(type power)
- (7) electric log NO
(yes or no)

(organization running log)

(8) how well bottom plugged Drive Point


DRILLERS REMARKS:

JUL 10 - 1969

MISS. Bd. OF
WATER COMMISSIONERS

If well telescopes please sketch and show depths.

GROUND LEVEL

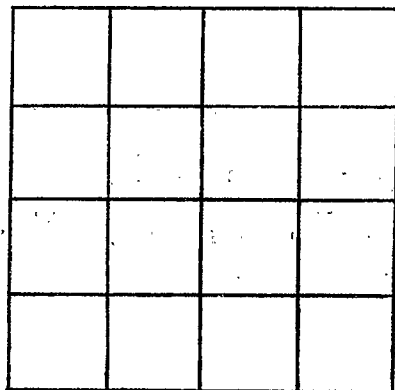

SECTION 5

Please indicate well location X.

ADDITIONAL INFORMATION

If more than one screen, show locations of each on sketch.