

YALO,
C 36

WATER WELL DRILLERS LOG

CODED

Date: 1-21, 1962, Driller: Jas. R. Lyne County Panola

8-21-62

(Name)

(1) Owner of Land: J. W. T. West

(Name)

Water Valley Miss.

(Address)

(2) Location: $\frac{1}{4}$, $\frac{1}{4}$, Sec. 18 T1R4

S W

5 miles West, of Water Valley

(distance)

(direction)

(Nearest Town)

(3) Topography: Flat

(Hilly)

(Flat)

(Level)

(4) Purpose of Well: Domestic

(Domestic Irrigation
Municipal, Industrial, Other)

Description & Color of Materials
Sand, Clay, Red Clay, Shell, etc.

Thick-
ness
Feet

Depth
Feet

Sand	0	40
Clay	40	60
Black Clay and sand	60	80
Water Sand	80	90

Information upon completion of well:

(1) Diameter 2 inches.

(2) Total Depth 94 feet.

(3) Water Level 50 feet below top of ground.

(4) Cased to 84, Size 2"


(5) Screen: Size 1 1/4, Length 6'

(6) Were any formations sealed against pollution?
_____ yes, _____ no.

If YES depth of formation _____

Why _____

Drillers Remarks: _____

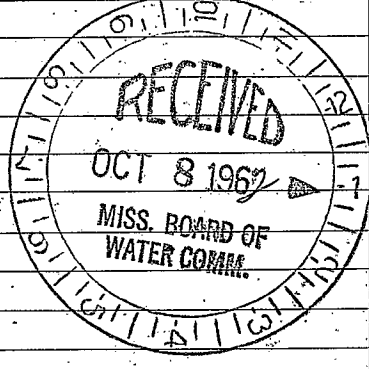

(Use Back Side)

Well No.

1952

1953

1954

[Faint, illegible text covering the majority of the page]