

WATER WELL DRILLERS LOG

~~FILED~~  
YALO.  
C37  
2-18-63

Date: 2-18, 1963, Driller: James R. Lipe County Pond IA  
(Name)


	Description & Color of Materials Sand, Clay, Red Clay, Shell, etc.	Thick- ness Feet	Depth Feet
(1) Owner of Land: <u>Bob Riley</u> (Name) <u>Water Valley</u> (Address)	<u>Clay &amp; sand</u>	<u>0</u>	<u>20</u>
(2) Location: <u>1/4</u> , <u>1/4</u> , Sec. <u>32</u> T <sup>10</sup> S R <sup>4</sup> W <u>2</u> miles <u>E</u> , of <u>Water Valley</u> (distance) (direction) (Nearest Town)	<u>gravel sand</u>	<u>20</u>	<u>30</u>
(3) Topography: <u>Flat</u> (Hilly) (Flat) (Level)	<u>Full heavy sand</u>	<u>50</u>	<u>84</u>
(4) Purpose of Well: <u>Domestic</u> (Domestic Irrigation Municipal, Industrial, Other)			

Information upon completion of well:

- (1) Diameter 2 inches.
- (2) Total Depth 84 feet.
- (3) Water Level 45 feet below top of ground.
- (4) Cased to 76', Size 2"
- (5) Screen: Size 1/4, Length 6'
- (6) Were any formations sealed against pollution?  
\_\_\_\_\_ yes, \_\_\_\_\_ no.

If YES depth of formation \_\_\_\_\_  
Why \_\_\_\_\_

Drillers Remarks: \_\_\_\_\_  
\_\_\_\_\_  
\_\_\_\_\_

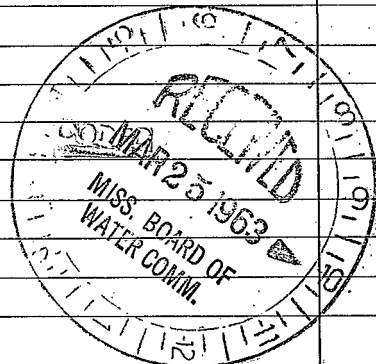

(Use Back Side)

Well No.

