

YALO.  
C 38  
3-18-63

MISSISSIPPI BOARD OF WATER COMMISSIONERS

CODED

WATER WELL DRILLERS LOG


Date: 3-18, 1963, Driller: James R. Lipe County Ponchartraine  
(Name)

	Description & Color of Materials Sand, Clay, Red Clay, Shell, etc.	Thick- ness Feet	Depth Feet
(1) Owner of Land: <u>D. H. Powell</u> (Name) <u>Water Valley</u> (Address)	<u>Clay</u>	<u>0</u>	<u>20</u>
(2) Location: <u>1/4</u> , <u>1/4</u> , Sec. <u>34</u> T <u>10</u> S <u>4</u> R <u>4</u> W <u>2</u> miles <u>No.</u> of <u>Water Valley</u> (distance) (direction) (Nearest Town)	<u>Sandy clay</u> <u>Clay &amp; gravel</u> <u>gravel &amp; sand</u> <u>W/Heavy Sand</u>	<u>20</u> <u>45</u> <u>62</u> <u>100</u>	<u>45</u> <u>65</u> <u>100</u> <u>133</u>
(3) Topography: _____ (Hilly) (Flat) (Level)			
(4) Purpose of Well: <u>Domestic</u> (Domestic Irrigation Municipal, Industrial, Other)			

Information upon completion of well:

- (1) Diameter 2 inches.
- (2) Total Depth 133 feet.
- (3) Water Level 85 feet below top of ground.
- (4) Cased to 125', Size 2"
- (5) Screen: Size 1/4, Length 6'
- (6) Were any formations sealed against pollution?  
\_\_\_\_\_ yes, \_\_\_\_\_ no.

If YES depth of formation \_\_\_\_\_  
Why \_\_\_\_\_  
Drillers Remarks: \_\_\_\_\_

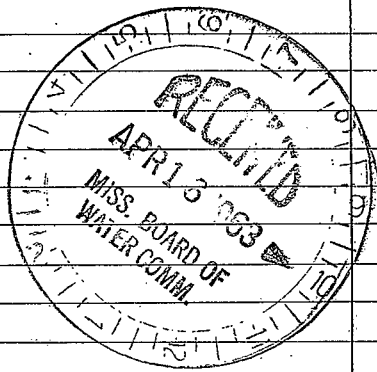

(Use Back Side)

Well No.

1000

1000

