

Yalobusha  
 C 41  
 3-11-65

MISSISSIPPI BOARD OF WATER COMMISSIONERS

James R. Lipe

CODED

WATER WELL DRILLERS LOG

Date: 3/11, 1965, Driller: Frankington County Yalobusha  
 (Name)


(1) Owner of Land: L. D. Jones  
 (Name)  
Water Valley  
 (Address)  
 (2) Location: 1/4, 1/4, Sec. 29 T10 R4 S W  
1 1/2 miles north of Water Valley  
 (distance) (direction) (Nearest Town)  
 (3) Topography: Hilly  
 (Hilly) (Flat) (Level)  
 (4) Purpose of Well: Domestic  
 (Domestic Irrigation  
 Municipal, Industrial, Other)

Description & Color of Materials Sand, Clay, Red Clay, Shell, etc.	Thick- ness Feet	Depth Feet
Red Clay	0	23
Sand and clay	23	43
" "	43	63
" "	68	83
Black Clay	83	103
Clay and sand	103	123
water sand	123	145

Information upon completion of well:

(1) Diameter 2 1/2 inches.  
 (2) Total Depth 145 feet.  
 (3) Water Level 80 feet below top of ground.  
 (4) Cased to 126, Size 2 1/2  
 (5) Screen: Size 1 1/2, Length 6'  
 (6) Were any formations sealed against pollution?  
 \_\_\_\_\_ yes, \_\_\_\_\_ no.

If YES depth of formation \_\_\_\_\_  
 Why \_\_\_\_\_  
 Drillers Remarks: \_\_\_\_\_

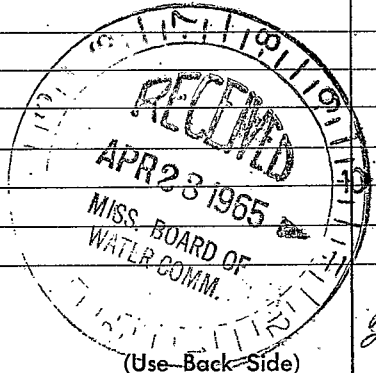

Well No. 22

