

Galobusha
C43
12-68

MISSISSIPPI
 BOARD OF WATER COMMISSIONERS
 416 North State Street
 Jackson, Mississippi 39201

CODED

WATER WELL DRILLERS LOG

date well completed 19 68 JAMES B. LIPE firm name Galobusha county well located

LANDOWNER: J. R. SMITH
Water Valley boat
landing on Enid dam
 (mailing address)

description of formations encountered	from	to
<u>Clay</u>	<u>0</u>	<u>20</u>
<u>Clay and sand</u>	<u>20</u>	<u>40</u>
<u>cc cc cc</u>	<u>40</u>	<u>60</u>
<u>black clay</u>	<u>60</u>	<u>80</u>
<u>cc cc</u>	<u>80</u>	<u>100</u>
<u>Water sand</u>	<u>100</u>	<u>119</u>


WELL LOCATION:
 sec. 8 T. 11 N. R. 4 E
7 miles West of Water Valley
 (distance) (direction) (nearest town)

WELL PURPOSE: home
 (home, irrigation, municipal, industrial)

WELL COMPLETION DATA:


- (1) diameter (inches) 4"
- (2) total depth (feet) 119
- (3) static water level (feet) 80 below above top of ground.
- (4) casing Plastic, 111
 (material) (depth)
8' if telescope see back.
 (size)
- (5) screen 8' 111
 (length) (depth to top)
4 Plastic
 (size) (material)
- (6) pump 1/2 20
 (HP) (yield gpm)
Elec.
 (type power)
- (7) electric log no
 (yes or no)
 (organization running log)
- (8) how well bottom plugged 4"
Plastic plug

DRILLERS REMARKS:

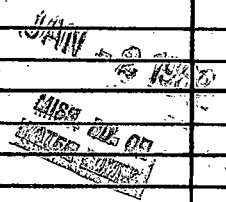

If well telescopes please sketch and show depths.

GROUND LEVEL

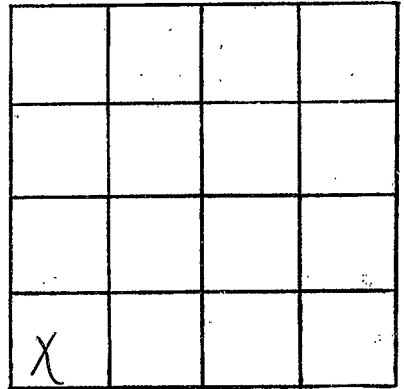

SECTION 8

Please indicate well location X.

ADDITIONAL INFORMATION

If more than one screen,
show locations of each on sketch.