

Yalobusha  
C 50  
8-14-68


MISSISSIPPI  
 BOARD OF WATER COMMISSIONERS  
 416 North State Street  
 Jackson, Mississippi 39201

CODED  
 CODED

WATER WELL DRILLERS LOG


Aug 14 1968 Roberson & Son Yalobusha  
 date well completed firm name county well located

LANDOWNER: <u>Carl Emanuel</u>	description of formations encountered	from	to
<u>Water Valley, Miss</u> (mailing address)	<u>Red Clay</u> <u>Blue Clay &amp; sand</u> <u>white sand &amp; clay</u> <u>white sand</u>	<u>0</u> <u>20</u> <u>130</u> <u>160</u>	<u>20</u> <u>130</u> <u>160</u> <u>180</u>
WELL LOCATION: sec. <u>30</u> T <u>10</u> N R <u>4</u> E <u>3</u> miles <u>NW</u> of <u>Water Valley</u> (distance) (direction) (nearest town)			
WELL PURPOSE: <u>Home</u> (home, irrigation, municipal, industrial)			
WELL COMPLETION DATA: (1) diameter (inches) <u>4"</u> (2) total depth (feet) <u>180</u> (3) static water level (feet) <u>120</u> below above top of ground. (4) casing: <u>plastic</u> <u>175</u> (material) (depth) <u>4</u> If telescope see back. (size) (5) screen <u>5ft</u> <u>175</u> (length) (depth to top) <u>4</u> <u>gravel packed</u> (size) (material) (6) pump <u>3/4</u> <u>12</u> (HP) (yield gpm) <u>1/4 HP</u> (type power) (7) electric log <u>No</u> (yes or no) (organization running log) (8) how well bottom plugged <u>Coped</u>			
DRILLERS REMARKS: <u>Plastic</u> <u>Water Well</u>			

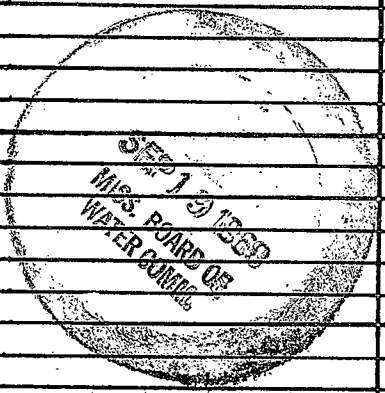

If well telescopes please sketch and show depths.

GROUND LEVEL

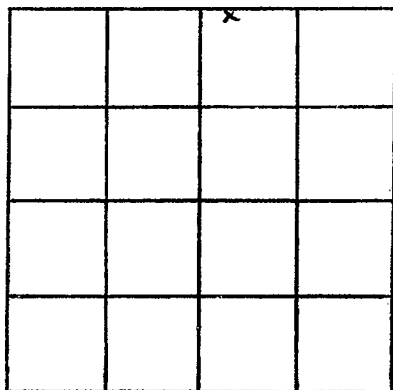

SECTION 80

Please indicate well location X.

ADDITIONAL INFORMATION

If more than one screen,  
show locations of each on sketch.