

YALO.

C 52

6-1-66

MISSISSIPPI BOARD OF WATER COMMISSIONERS

WATER WELL DRILLERS LOG

Date: 6-1, 1966, Driller: J B Cain County Panola

(Name)

(1) Owner of Land: Horey Ross

(Name)

Water Valley

(Address)

Description & Color of Materials
Sand, Clay, Red Clay, Shell, etc.

B no of
Sand

Thick-
ness
Feet

0
50

Depth
Feet

50
160

(2) Location: 1/4, 1/4, Sec. 34-10-4

4 miles E of Water Valley

(distance)

(direction)

(Nearest Town)

(3) Topography: Hilly

(Hilly)

(Flat)

(Level)

(4) Purpose of Well: Home

(Domestic Irrigation
Municipal, Industrial, Other)

Information upon completion of well:

(1) Diameter 4 inches.

(2) Total Depth 160 feet.

(3) Water Level 140 feet below top of ground.

(4) Cased to 160, Size 4

(5) Screen: Size 6, Length 5

(6) Were any formations sealed against pollution?


yes, no.

If YES depth of formation

Why

Drillers Remarks:

Screen Gravel Packed
glued on

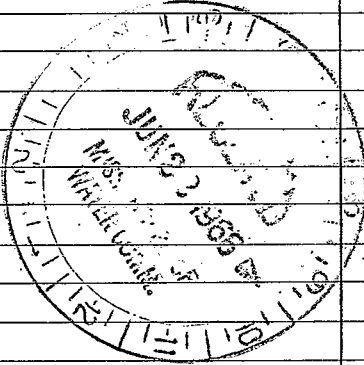

(Use Back Side)

Well No.

