

MISSISSIPPI BOARD OF WATER COMMISSIONERS

YALOBUSNA

YALOB.

WATER WELL DRILLERS LOG

CODED

N300

C53  
11-10-60

Date: 11-10, 1960, Driller: ELLIOTT H. HUE County: Yalobusna

(Name)

- (1) Owner of Land: P. T. Sanson  
(Name)  
Water Valley, Miss - R2  
(Address)
- (2) Location: 1/4, 1/4, Sec 6  
1/2 miles West, of Water Valley  
(distance) (direction) (Nearest Town)
- (3) Topography: Hilly  
(Hilly) (Flat) (Level)
- (4) Purpose of Well: Domestic  
(Domestic Irrigation  
Municipal, Industrial, Other)

Description & Color of Materials  
Sand, Clay, Red Clay, Shell, etc.

Thick-  
ness  
Feet

Depth  
Feet

SAND

90' 70'


Information upon completion of well:

- (1) Diameter 2 inches.
- (2) Total Depth 70' feet.
- (3) Water Level 40' feet below top of ground.
- (4) Cased to \_\_\_\_\_, Size \_\_\_\_\_
- (5) Screen: Size 2", Length \_\_\_\_\_
- (6) Were any formations sealed against pollution?  
\_\_\_\_\_ yes, \_\_\_\_\_ no.

If YES depth of formation \_\_\_\_\_

Why \_\_\_\_\_

Drillers Remarks: \_\_\_\_\_

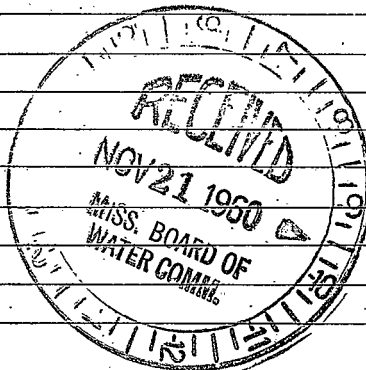

(Use Back Side)

Well No.  
N300

11