

YALO.

MISSISSIPPI BOARD OF WATER COMMISSIONERS

C 54

5-28-65

WATER WELL DRILLERS LOG

CODED

CODED

Date: 5-28, 1965, Driller: Gerry Peterson County Panola
(Name)

(1) Owner of Land: Casper Wilson
(Name)

Water Valley, Miss
(Address)

(2) Location: $\frac{1}{4}$, 3 1/4, Sec. 11 4 T. R.

_____ miles _____ of _____
(distance) (direction) (Nearest Town)

(3) Topography: _____ _____
(Hilly) (Flat) (Level)

(4) Purpose of Well: Home
(Domestic Irrigation
Municipal, Industrial, Other)

Description & Color of Materials Sand, Clay, Red Clay, Shell, etc.	Thick- ness Feet	Depth Feet
<u>Clay + Sand</u>	<u>0</u>	<u>30</u>
<u>Blue Clay</u>	<u>30</u>	<u>60</u>
<u>Sand</u>	<u>60</u>	<u>75</u>

Information upon completion of well:

(1) Diameter 2 inches.

(2) Total Depth 75 feet.

(3) Water Level 70 feet below top of ground.

(4) Cased to 70, Size 2

(5) Screen: Size 3 in, Length 5 ft.


(6) Were any formations sealed against pollution?

_____ yes, _____ no.

If YES depth of formation _____

Why _____

Drillers Remarks: Plastic well

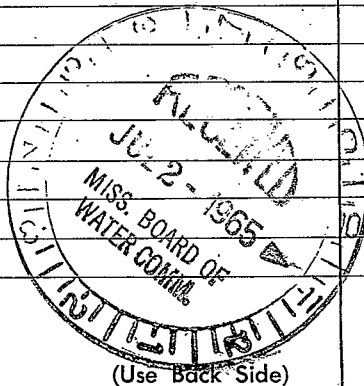

(Use Back Side)

Well No.

