

Yalobusha
C 55
2-19-70

MISSISSIPPI
BOARD OF WATER COMMISSIONERS
416 North State Street
Jackson, Mississippi 39201

CODED

WATER WELL DRILLERS LOG

2-19-1970 date well completed LIPE WELL CO. firm name YALOBUSHIA county well located

LANDOWNER:
Camp Ground Baptist Church
Water Valley, Miss
(mailing address)

description of formations encountered	from	to
top soil + sand	0	20
clay	20	40
clay	40	60
sand	60	80
sand	80	100
sand	100	120
sand	120	140
sand	140	164

WELL LOCATION:
sec. 29 T. 10 N R. 4 E
2 miles N of Water Valley
(distance) (direction) (nearest town)

WELL PURPOSE: home
(home, irrigation, municipal, industrial)

WELL COMPLETION DATA:

(1) diameter (inches) 4"

(2) total depth (feet) 164'

(3) static water level (feet) 90' ^{below} top of ground

(4) casing PVC (material), 154' (depth)
4" (size) if telescope see back.

(5) screen 10' (length), 154' (depth to top)
4" (size), PVC + silica (material)

(6) pump 3/4 (HP), 8 (yield gpm)
elec (type power)

(7) electric log NO (yes or no)
(organization running log)

(8) how well bottom plugged PVC cap

CODED


MAR 5 - 1970

MISS. DE. OF
WATER COMM.

DRILLERS REMARKS:

If well telescopes please sketch and show depths.

GROUND LEVEL

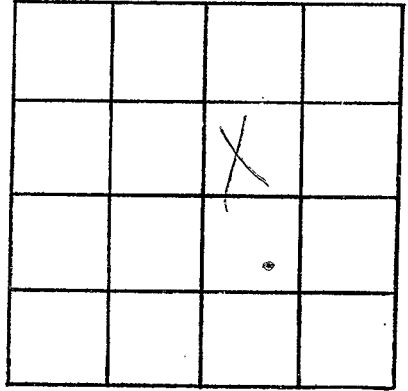

SECTION 29

Please indicate well location X.

ADDITIONAL INFORMATION

If more than one screen,
show locations of each on sketch.