

YALO.

MISSISSIPPI BOARD OF WATER COMMISSIONERS

059

WATER WELL DRILLERS LOG

9-28-62

28 62

J. B. Cain

1 hole

Date: \_\_\_\_\_, 19\_\_\_\_, Driller: \_\_\_\_\_ County \_\_\_\_\_

(Name)

CODED

CODED

Hubert Harmon

(1) Owner of Land: Hubert Harmon  
Coffeyville, Miss.

(2) Location: 22 1154  
10 SE 1/4 of Coffeyville  
miles (distance) 5 miles (direction) of \_\_\_\_\_ (Nearest Town)

(3) Topography: (Hilly) None (Flat) (Level)

(4) Purpose of Well: \_\_\_\_\_  
(Domestic Irrigation, Municipal, Industrial, Other)

Description & Color of Materials  
(Sand, Clay, Red Clay, Shell, etc.)

Thick-  
ness  
Feet

Depth  
Feet

<u>Clay</u>	<u>0</u>	<u>20</u>
<u>Blue</u>	<u>30</u>	<u>30</u>
<u>Clay</u>	<u>490</u>	<u>568</u>

Information upon completion of well:

(1) Diameter 2 inches

(2) Total Depth 568 feet

(3) Water Level 32 feet below top of ground

(4) Cased to 104 Size 6 FT

(5) Screen: Size \_\_\_\_\_ Length \_\_\_\_\_


(6) Were any formations sealed against pollution?

\_\_\_\_\_ yes, \_\_\_\_\_ no.

If YES depth of formation \_\_\_\_\_

Why \_\_\_\_\_

Drillers Remarks: \_\_\_\_\_

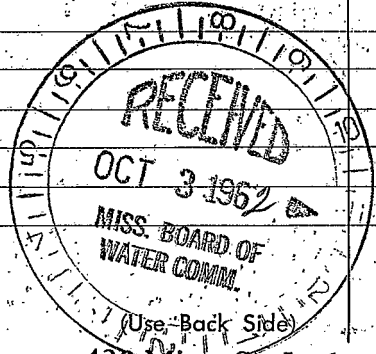

Well No.

