

YALOBUSHA
C62
7-2-71

MISSISSIPPI
BOARD OF WATER COMMISSIONERS
416 North State Street
Jackson, Mississippi 39201

CODED

WATER WELL DRILLERS LOG

7-2-71 date well completed 71 Sartas Well Supply Drubush county well located firm name

LANDOWNER: Larry Bell
Water Valley, Miss
(mailing address)

description of formations encountered	from	to
Top clay	1	16
Red Sand	16	20
White & Red sand	20	50
water sand	50	60

WELL LOCATION:
sec 28 T 10 N R 4 E
2 miles N of Water Valley
(distance) (direction) (nearest town)

WELL PURPOSE: Drain
(home, irrigation, municipal, industrial)

- WELL COMPLETION DATA:
- (1) diameter (inches) 2"
 - (2) total depth (feet) 68'
 - (3) static water level (feet) 20 ^{below}/_{above} top of ground.
 - (4) casing 4-V.G.P., 55'
(material) (depth)
2" If telescope see back.
(size)
 - (5) screen 5', 5 1/2'
(length) (depth to top)
1 1/2", SS-GAUZE
(size) (material)
 - (6) pump 1/2, 5
(HP) (yield gpm)
E.
(type power)
 - (7) electric log NO
(yes or no)

(organization running log)
 - (8) how well bottom plugged

CODED


JUL 15 1971

DRILLERS REMARKS:

MISS. Bd. of
WATER COMMISSIONERS

If well telescopes please sketch and show depths.

GROUND LEVEL

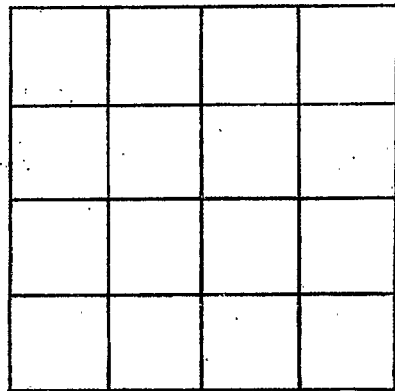

SECTION _____

Please indicate well location X.

ADDITIONAL INFORMATION

If more than one screen,
show locations of each on sketch.