

Yalobusha
C. 64
5-3-71

MISSISSIPPI
 BOARD OF WATER COMMISSIONERS
 416 North State Street
 Jackson, Mississippi 39201

CODED

WATER WELL DRILLERS LOG

MAY 3 1971 LIPE WELL CO. YALOBUSHA CO.
 date well completed firm name county well located

LANDOWNER:	description of formations encountered.	from	to
<u>Clayton Sproose</u>			
<u>WATER VALLEY, MISS</u> (mailing address)	<u>sand & gravel</u>	<u>20</u>	<u>60</u>
	<u>sand</u>	<u>100</u>	<u>183</u>

WELL LOCATION:
 sec. 26 T 10 N R 4 E
5 miles NE of Water Valley
 (distance) (direction) (nearest town)

WELL PURPOSE: None
 (home, irrigation, municipal, industrial)

WELL COMPLETION DATA:

(1) diameter (inches) 4"

(2) total depth (feet) 183'

(3) static water level (feet) 100 below above top of ground.

(4) casing PVC 173'
 (material) (depth)
4" if telescope see back.
 (size)

(5) screen 10' 173
 (length) (depth to top)
4" PVC & Silica
 (size) (material)

(6) pump 3/4 10
 (HP) (yield gpm)
elec
 (type power)

(7) electric log no
 (yes or no)
 (organization running log)

(8) how well bottom plugged PVC cap

CODED


OCT 12 1971

DRILLERS REMARKS:

MISS. Bd. OF
 WATER COMM.

If well telescopes please sketch and show depths.

GROUND LEVEL

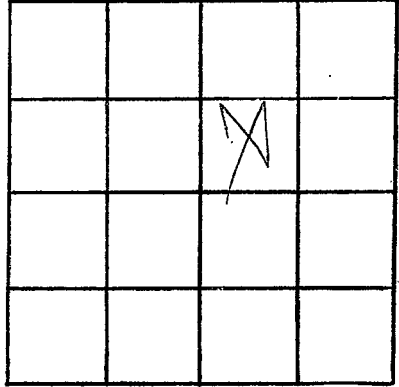

SECTION 26

Please indicate well location X.

ADDITIONAL INFORMATION

If more than one screen,
show locations of each on sketch.