

**CODED****ELOG 50**

**Yalobusha**  
**C 65**  
**10-13-71**

MISSISSIPPI  
 BOARD OF WATER COMMISSIONERS  
 416 North State Street  
 Jackson, Mississippi 39201

**FEB 25 1972****WATER WELL DRILLERS LOG**


~~Feb 28~~ 1972 Robert E. Ratliff Co., Inc. Yalobusha  
 date well completed firm name county well located

LANDOWNER: <u>Tri-Lake East Well Water Association</u> <u>Water Valley, Miss.</u> (mailing address)	description of formations encountered	from	to
	<u>Red Clay</u>	<u>0</u>	<u>47</u>
	<u>sand</u>	<u>47</u>	<u>180</u>
	<u>fine sand</u>	<u>180</u>	<u>278</u>
	<u>Clay</u>	<u>278</u>	<u>570</u>
	<u>Good White sand</u>	<u>570</u>	<u>620</u>
	<u>fine sand</u>	<u>620</u>	<u>675</u>
<b>WELL LOCATION:</b>			
sec <u>26</u> T <u>10</u> N R <u>4</u> E			
<u>5</u> miles <u>East</u> of <u>Water Valley</u>			
(distance) (direction) (nearest town)			
<b>WELL PURPOSE:</b> <u>Industrial</u> (home, irrigation, municipal, industrial)			
<b>WELL COMPLETION DATA:</b>			
(1) diameter (inches) <u>7"</u>			
(2) total depth (feet) <u>620'</u>			
(3) static water level (feet) <u>240</u> below top of ground.			
(4) casing <u>Black Steel</u> <u>572'</u> (material) (depth)			
<u>7" x 4"</u> If telescope see back. (size)			
(5) screen <u>30'</u> <u>590'</u> (length) (depth to top)			
<u>4"</u> <u>S.S.</u> (size) (material)			
(6) pump <u>20</u> <u>100</u> (HP) (yield gpm)			
<u>Electric</u> (type power)			
(7) electric log <u>Yes</u> (yes or no)			
<u>T.S. &amp; S.</u> (organization running log)			
(8) how well bottom plugged <u>BPV-4"</u>			
<b>DRILLERS REMARKS:</b>			

**CODED**

(K)

If well telescopes please sketch and show depths.

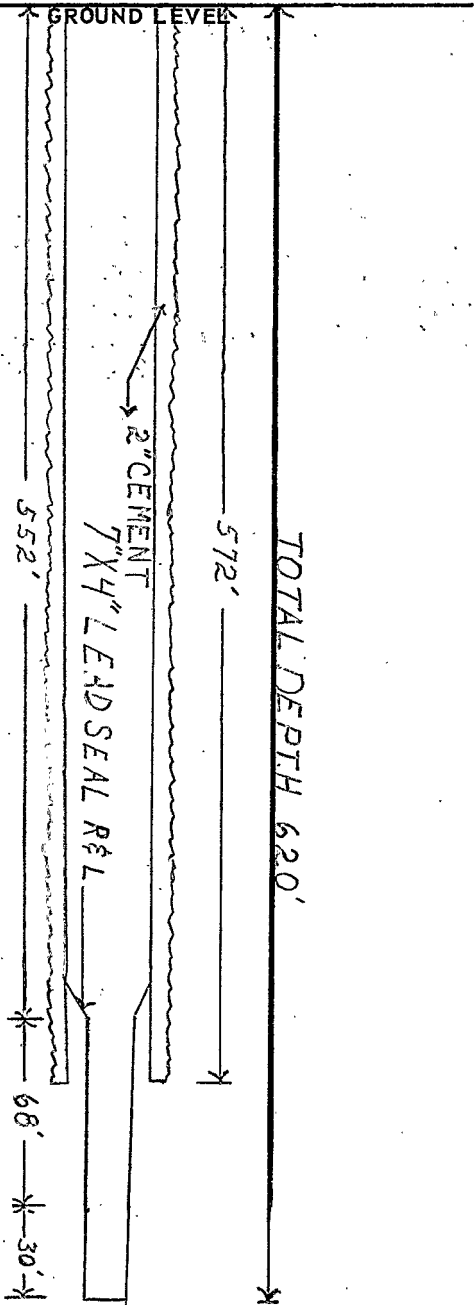

		26	
		X	

SECTION 26

Please indicate well location X.

ADDITIONAL INFORMATION


If more than one screen, show locations of each on sketch.