

ALOBUSHA

C 70

8-29-73

MISSISSIPPI
 BOARD OF WATER COMMISSIONERS
 416 North State Street
 Jackson, Mississippi 39201

WATER WELL DRILLERS CODED

8-29

James R. Lipe

Jalobusha

date well completed

firm name

county well located

LANDOWNER:

Frank Hill

Water Valley Miss.

(mailing address)

description of formations encountered

Top soil

red sand

white sand

from

to

0 20

20 40

40 94

WELL LOCATION:

sec. 28 T 10 N R 4 E

3 miles north of Water Valley

(distance) (direction) (nearest town)

WELL PURPOSE:

(home irrigation, municipal, industrial)

WELL COMPLETION DATA:

- (1) diameter (inches) 4
- (2) total depth (feet) 94
- (3) static water level (feet) 60 below above top of ground.

(4) casing PVC, 84 (material), (depth)

4 (size) if telescope see back.

(5) screen 10, 84 (length), (depth to top)

4, PVC (size), (material)

(6) pump 3/4, 10 (HP), (yield gpm)

elec. (type power)

(7) electric log no (yes or no)

no (organization running log)

(8) how well bottom plugged PVC Plug


CODED

SEP 6 1973

DRILLERS REMARKS:

If well telescopes please sketch and show depths.

GROUND LEVEL

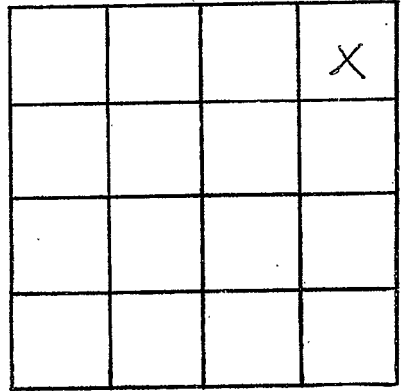

SECTION 28

Please indicate well location X.

ADDITIONAL INFORMATION

If more than one screen,
show locations of each on sketch.