

MISSISSIPPI DEPARTMENT OF NATURAL RESOURCES

Bureau of Land and Water Resources

Southport Mall

P.O. Box 10631

Jackson, Mississippi 39209

WATER WELL DRILLERS LOG

CODED

YALOBUSHA
CL-2318
C72
1-14-83

Log # 72-14 19 83 Layne Central Co. Yalobusha
 date well completed firm name county well located

LANDOWNER: Town of Water Valley, Ms
 (mailing address)

description of formations encountered	from	to
clay	0	10
Blue sand	10	20
coarse sand	20	40
C. sand / fine gravel	40	92
white clay	92	94

WELL LOCATION: sec. 4 T 11 S R. 4 E W
 miles (distance) of (direction) of (nearest town)

WELL PURPOSE: municipal
 (home, irrigation, municipal, industrial)

- WELL COMPLETION DATA:
- (1) diameter (inches) 20"
 - (2) total depth (feet) 94'
 - (3) static water level (feet) 4' 5" below above top of ground.
 - (4) casing steel 91' 4"
 (material) (depth)
12" if telescope see back.
 (size)
 - (5) screen 40' 8" 50'
 (length) (depth to top)
10" stainless steel
 (size) (material)
 - (6) pump 25 600
 (HP) (yield gpm)
electric
 (type power)
 - (7) electric log Yes
 (yes or no)
MSG S
 (organization running log)
 - (8) how well bottom plugged 3' blank

CODED

DEPT. OF NATURAL RESOURCES
 BUREAU OF LAND & WATER RESOURCES

MAY 12 1983


RECEIVED

DRILLERS REMARKS:



If well telescopes please sketch and show depths.

GROUND LEVEL

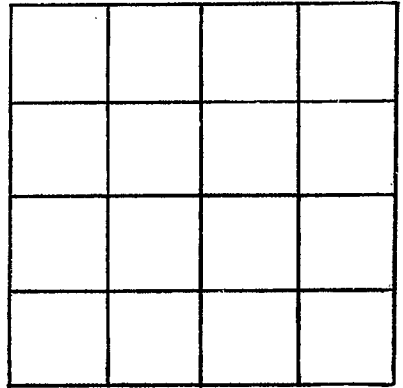

SECTION _____

Please indicate well location X.

ADDITIONAL INFORMATION

If more than one screen,
show locations of each on sketch.