

YALOBUSHA  
 CL-2318  
 C73  
 1-17-83

MISSISSIPPI  
 BOARD OF WATER COMMISSIONERS  
 416 North State Street  
 Jackson, Mississippi 39201

CODED

WATER WELL DRILLERS LOG

Log # 73 1-17 1983 Layne-Central Co. Yalobuska  
 date well completed firm name county well located

LANDOWNER:	description of formations encountered	from	to
<u>Town of Water Valley, Mo</u>			
(mailing address)	<u>swampstone clay</u>	<u>12</u>	<u>26</u>
#2 WELL LOCATION:	<u>coarse sand</u>	<u>20</u>	<u>40</u>
sec. <u>4</u> T. <u>11</u> S. R. <u>4</u> E. W.	<u>c. sand / fine gravel</u>	<u>40</u>	<u>91</u>
miles _____ of _____	<u>white clay</u>	<u>91</u>	<u>94</u>
(distance) (direction) (nearest town)			
WELL PURPOSE: <u>Municipal</u>			
(home, irrigation, municipal, industrial)			
WELL COMPLETION DATA:			
(1) diameter (inches) <u>20"</u>			
(2) total depth (feet) <u>93'8"</u>			
(3) static water level (feet) <u>6'5"</u> below top of ground.			
(4) casing <u>steel</u> <u>90'8"</u> (material) (depth)			
<u>12"</u> (size) if telescope see back.			
(5) screen <u>40'2"</u> <u>49'10"</u> (length) (depth to top)			
<u>10"</u> (size) <u>stainless steel</u> (material)			
(6) pump <u>25</u> <u>600</u> (HP) (yield gpm)			
<u>electric</u> (type power)			
(7) electric log <u>Yes</u> (yes or no)			
<u>M &amp; G S</u> (organization running log)			
(8) how well bottom plugged <u>3' Blank</u>			
DRILLERS REMARKS:			

DEPT. OF NATURAL RESOURCES  
 BUREAU OF LAND & WATER RESOURCES


MAY 12 1983

RECEIVED

8

If well telescopes please sketch and show depths.

GROUND LEVEL

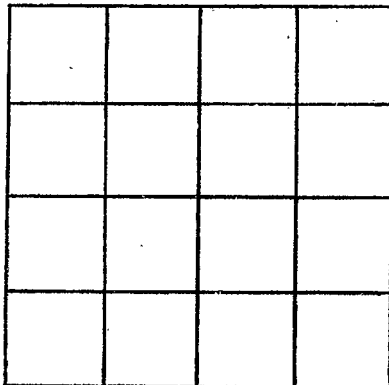

SECTION \_\_\_\_\_

Please indicate well location X.

ADDITIONAL INFORMATION

If more than one screen, show locations of each on sketch.