

YALOBUSHA

C 74

3-15-84

Ely #74

MISSISSIPPI
BOARD OF WATER COMMISSIONERS
416 North State Street
Jackson, Mississippi 39201

CODED

WATER WELL DRILLERS LOG

1984 Herndon Well & Supply, Inc. Yalobusha
date well completed firm name county well located

LANDOWNER:	description of fomations encountered	from	to
Tri-Lakes Water Ass'n., Inc. Water Valley, MS	Red Clay	0	20
(mailing address)	White Sand	20	60
WELL LOCATION:	White Clay	60	65
sec. 27 T. 10 N. x S R. 7 E	Sand	65	140
3 miles NE of Water Valley	Clay	140	150
(distance) (direction) (nearest town)	Sand	150	220
WELL PURPOSE: Municipal (home, irrigation, municipal, industrial)	White Clay	220	240
WELL COMPLETION DATA:	Clay	240	440
(1) diameter (inches) 10 x 6"	Sand	440	450
(2) total depth (feet) 633.6'	Clay	450	600
(3) static water level (feet) 173.3 below top of ground.	Sand	600	660
(4) casing Steel, 605' (material) (depth)	Clay	660	670
10" (size) If telescope see back.	Sand	670	680
(5) screen 30' 8" (length) , 605' (depth to top)	Clay	680	710
6" (size) , SS Ribbed (material)			
(6) pump 40 (HP) 214 (yield gpm)			
electric (type power)			
(7) electric log Yes (yes or no)			
Bureau of Geology (organization running log)			
(8) how well bottom plugged 6" BWV			
DRILLERS REMARKS:			

DEPT. OF NATURAL RESOURCES
BUREAU OF LAND & WATER RESOURCES

APR - 9 1984

RECEIVED

②

If well telescopes please sketch and show depths.


GROUND LEVEL

Top of LAP
540'

Top of Screens
605'

Bottom Well
633'6"

If more than one screen, show locations of each on sketch.

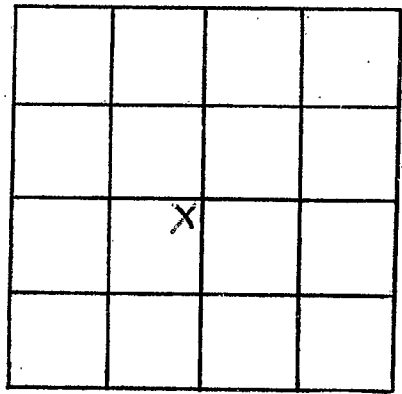

SECTION _____

Please indicate well location X.

ADDITIONAL INFORMATION

A series of horizontal lines for writing additional information.