

Yalobusha
C 2550
5/8/76

MISSISSIPPI
 BOARD OF WATER COMMISSIONERS
 416 North State Street
 Jackson, Mississippi 39201

WATER WELL DRILLERS LOG

May 8 1976 North Miss Well Drilling Yalobusha
 date well completed firm name county well located


LANDOWNER: <u>Leaning Steer</u>	description of formations encountered	from	to
<u>Water Valley</u> (mailing address)			
WELL LOCATION: sec. <u>14</u> T. <u>11</u> N R. <u>4</u> E W. <u>L</u> <u>4</u> miles <u>S-E</u> of <u>Water Valley</u> (distance) (direction) (nearest town)	<u>Sand & Clay Struck</u>	<u>0</u>	<u>82</u>
WELL PURPOSE: (home, irrigation, municipal, industrial)	<u>Water Sand</u>	<u>82</u>	<u>92</u>
WELL COMPLETION DATA: (1) diameter (inches) <u>2"</u> (2) total depth (feet) <u>92</u> (3) static water level (feet) <u>63</u> below top of ground. (4) casing <u>Plastic</u> , <u>82</u> (material) (depth) (size) If telescope see back. (5) screen <u>10'</u> , <u>92</u> (length) (depth to top) <u>2"</u> , <u>Slot Plastic</u> (size) (material) (6) pump <u>3/4</u> , <u>5</u> (HP) (yield gpm) <u>Elec</u> (type power) (7) electric log <u>No</u> (yes or no) (organization running log) (8) how well bottom plugged <u>Plug</u>			
DRILLERS REMARKS:			

MAY 11 1976

MISSISSIPPI BOARD OF WATER COMMISSIONERS

If well telescopes please sketch and show depths.

GROUND LEVEL

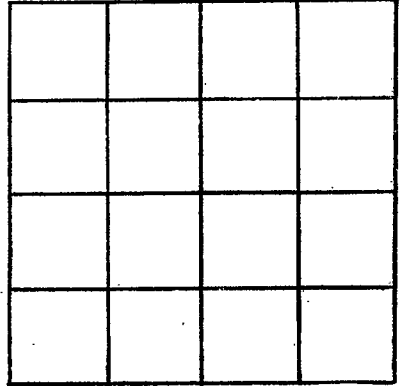

SECTION _____

Please indicate well location X.

ADDITIONAL INFORMATION

If more than one screen, show locations of each on sketch.