

MISSISSIPPI DEPARTMENT OF NATURAL RESOURCES

Bureau of Land and Water Resources

Southport Mall

P.O. Box 10631

Jackson, Mississippi 39209

WATER WELL DRILLERS LOG

Yazobusha
Co.

4-26 1991 Lipe Well & Supply Co. Inc. Yazobusha
date well completed firm name county well located


LANDOWNER: HORACE HARRISON
Rt. 2 Box 596
Oxford, MS. 38655
(mailing address)

WELL LOCATION:
sec. 26 T-11 N 5 R-4 E W
5 miles (distance) W (direction) of Waterbury (nearest town)

WELL PURPOSE:
(home, irrigation, municipal, industrial)

- WELL COMPLETION DATA:
- (1) diameter (inches) 4
 - (2) total depth (feet) 108
 - (3) static water level (feet) _____ below above top of ground.
 - (4) casing PVC 98 (material) (depth)
4 (size) if telescope see back.
 - (5) screen 10 98 (length) (depth to top)
4 (size) PVC (material)
 - (6) pump 1/2 (HP) _____ (yield gpm)
(type power)
 - (7) electric log (yes or no) (no)
(organization running log)
 - (8) how well bottom plugged Capped

description of formations encountered	from	to
Top soil - sand streaks of clay	0	20
Sand - streaks of clay	20	40
sand streaks of clay	40	60
sand streaks of clay	60	80
sand streaks of clay	80	100
sand 108' then rock	100	120

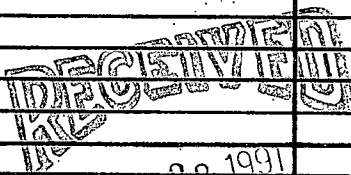


MAR 28 1991

Dept. of Environmental Quality
Bureau of Land & Water Resources

DRILLERS REMARKS:

If well telescopes please sketch and show depths.

GROUND LEVEL

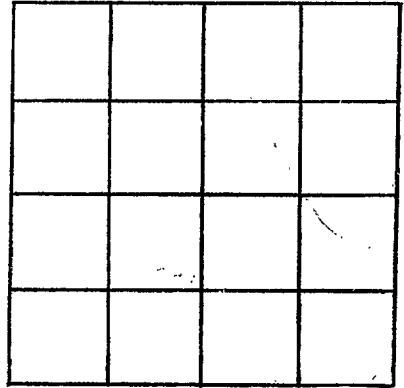

SECTION 26

Please indicate well location X.

ADDITIONAL INFORMATION

If more than one screen,
show locations of each on sketch.