

YALO.

MISSISSIPPI BOARD OF WATER COMMISSIONERS

D 10

WATER WELL DRILLERS LOG

CODED

11-18-64

Date: 11-18, 1964, Driller: Frank Zylar ^{pipe} County: Panola
(Name)

(1) Owner of Land: L.A. Tubbs
(Name)

Water Valley
(Address)

(2) Location: 1/4, 1/4, Sec. 30 T11 R3 S W

1.5 miles S.E. of Water Valley
(distance) (direction) (Nearest Town)

(3) Topography: Hilly
(Hilly) (Flat) (Level)

(4) Purpose of Well: Domestic
(Domestic Irrigation Municipal, Industrial, Other)

Description & Color of Materials
Sand, Clay, Red Clay, Shell, etc.

Clay & Sand 0 60

Gravel sand 60 90

1/2" sand 90 117

Thick-ness Feet

Depth Feet

Information upon completion of well:

(1) Diameter 2 inches.

(2) Total Depth 117 feet.

(3) Water Level 60 feet below top of ground.

(4) Cased to 108, Size 2


(5) Screen: Size 1/4, Length 6'

(6) Were any formations sealed against pollution?
yes, no.

If YES depth of formation

Why

Drillers Remarks:

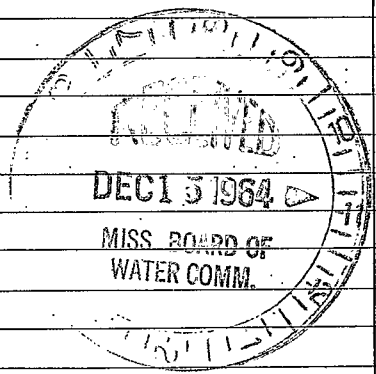

(Use Back Side)

Well No. 15

