

Zalobusha  
D 2000  
5/5/76

MISSISSIPPI  
 BOARD OF WATER COMMISSIONERS  
 416 North State Street  
 Jackson, Mississippi 39201

15F

WATER WELL DRILLERS LOG

5-5 1976 Lipe Well Co. Zalobusha  
 date well completed firm name county well located

LANDOWNER:  
Kenneth Kelso  
Water Valley Miss  
 (mailing address)

WELL LOCATION:  
 sec. 31 T 10 N R 3 E  
6 miles East of Water Valley  
 (distance) (direction) (nearest town)

WELL PURPOSE:  
 (home irrigation, municipal, industrial)

- WELL COMPLETION DATA:
- (1) diameter (inches) 4
  - (2) total depth (feet) 361
  - (3) static water level (feet) 140 below above top of ground.
  - (4) casing PVC 349  
 (material) (depth)  
4 If telescope see back.  
 (size)
  - (5) screen 12 349  
 (length) (depth to top)  
4 PVC  
 (size) (material)
  - (6) pump 4 10  
 (HP) (yield gpm)  
elec  
 (type power)
  - (7) electric log yes  
 (yes or no)  
no  
 (organization running log)
  - (8) how well bottom plugged PVC  
cap


description of formations encountered	from	to
Top soil	0	20
red sand	20	40
" "	40	60
Coarse white sand	60	80
" "	80	100
clay	100	120
sand and clay	120	140
" " "	140	160
clay	160	180
" "	180	200
" "	200	220
sand and clay	220	240
" " "	240	260
sand fine	260	280
" "	280	300
good sand	300	320
good	320	361

REC'D  
 JUN 7 1976  
 MISSISSIPPI BOARD OF WATER COMMISSIONERS  
 OFFICE RD. OF WATER

DRILLERS REMARKS:

If well telescopes please sketch and show depths.

GROUND LEVEL

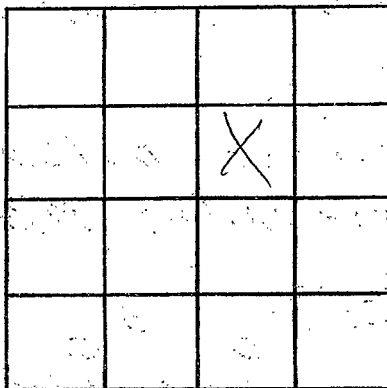

SECTION 31

Please indicate well location X.

ADDITIONAL INFORMATION

If more than one screen, show locations of each on sketch.