

VALOBUSHA
 D 2001
 3-3-77

MISSISSIPPI
 BOARD OF WATER COMMISSIONERS
 416 North State Street
 Jackson, Mississippi 39201

WATER WELL DRILLERS LOG

March 3 1977 date well completed
 177 North Miss Well Drilling Valobusha firm name
 county well located

LANDOWNER: Wallace Whelan
Water Valley
 (mailing address)

description of formations encountered	from	to
Clay	0	20
Sand	20	80
Water sand	80	110

WELL LOCATION:
 sec. 24 T 11 N R 4 E
 5 miles SE of Water Valley
 (distance) (direction) (nearest town)

WELL PURPOSE: Home
 (home, irrigation, municipal, industrial)


- WELL COMPLETION DATA:
- (1) diameter (inches) 4"
 - (2) total depth (feet) 110
 - (3) static water level (feet) 80 below top of ground.
 - (4) casing Plastic, 110,
 (material) (depth)
 (size) If telescope see back.
 - (5) screen 10',
 (length) (depth to top)
4, slat plastic
 (size) (material)
 - (6) pump 1/2, 10
 (HP) (yield gpm)
Electric
 (type power)
 - (7) electric log No
 (yes or no)
 - (organization running log)
 - (8) how well bottom plugged Plug

DRILLERS REMARKS:

RECEIVED
 MAR 21 1977
 WATER COMMISSIONERS

If well telescopes please sketch and show depths.

GROUND LEVEL

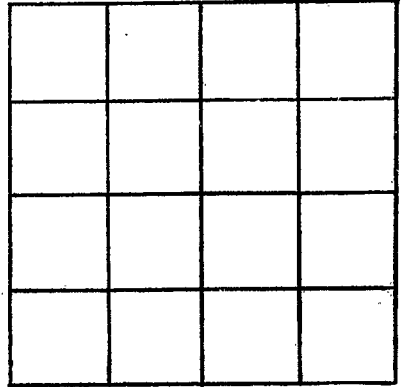

SECTION _____

Please indicate well location X.

ADDITIONAL INFORMATION

If more than one screen, show locations of each on sketch.