

YALOBUSHA
D
8-5-77

MISSISSIPPI
 BOARD OF WATER COMMISSIONERS
 416 North State Street
 Jackson, Mississippi 39201

WATER WELL DRILLERS-LOG

8-5-77
 date well completed

15E North Miss Well Drilling Yallobuscha
 firm name county/well located

LANDOWNER: **F.E. Morgan**
Water Valley Miss

description of formations encountered from to

(mailing address)

Clay	0	12
Sand	12	52
Rock	52	52 1/2
Blue Clay	52 1/2	80
Rock	80	81
Blue Clay	81	140
Hard Rock	140	141
Blue Clay	141	210
Hard Rock	210	211
Blue Clay	211	280
Sand	280	310

WELL LOCATION:

sec. **29** T. **10** N. ? R. **3** E
5 miles **SNE** of **Water Valley**
 (distance) (direction) (nearest town)

WELL PURPOSE: **Home**
 (home, irrigation, municipal, industrial)

WELL COMPLETION DATA:

- (1) diameter (inches) **4"**
- (2) total depth (feet) **310**
- (3) static water level (feet) **110** below top of ground above
- (4) casing **Plastic** **180**
 (material) (depth)
 (size) If telescope see back.
- (5) screen **NON**
 (length) (depth to top)
 (size) (material)
- (6) pump **3/4** **10**
 (HP) (yield gpm)
Elect
 (type power)
- (7) electric log **NO**
 (yes or no)

(organization running log)

(8) how well bottom plugged **OPEN**


DRILLERS REMARKS:
Clusia Cain

RECEIVED
 AUG 18 1977

MISS. DEPT. OF WATER RESOURCES

If well telescopes please sketch and show depths.

GROUND LEVEL

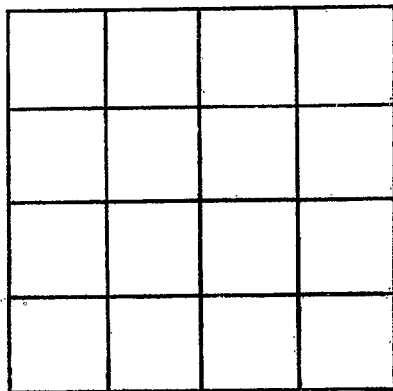

SECTION _____

Please indicate well location X.

ADDITIONAL INFORMATION

If more than one screen, show locations of each on sketch.