

YALOBESHA
 D 2003
 12-10-78

MISSISSIPPI
 BOARD OF WATER COMMISSIONERS
 416 North State Street
 Jackson, Mississippi 39201

WATER WELL DRILLERS LOG

Yalobesha
Yalobesha

Dec 10 19 *78* *North Miss Well Drilling* *Yalobesha*
 date well completed firm name county well located


LANDOWNER: <i>Mr Reed</i>	description of formations encountered	from	to
(mailing address)			
	<i>Clay</i>	<i>0</i>	<i>35</i>
	<i>Sand + Clay Strata</i>	<i>35</i>	<i>165</i>
WELL LOCATION:			
sec. <i>4</i> T. <i>11</i> N. R. <i>3</i> E.			
Sc. <i>6</i> miles <i>E</i> of <i>Walthamville</i>			
(distance) (direction) (nearest town)			
WELL PURPOSE: <i>Home</i>			
(home, irrigation, municipal, industrial)			
WELL COMPLETION DATA:			
(1) diameter (inches) <i>4"</i>			
(2) total depth (feet) <i>165</i>			
(3) static water level (feet) <i>120</i> below above top of ground.			
(4) casing <i>Plastic</i> , <i>165</i> , (material) (depth)			
(size) if telescope see back.			
(5) screen <i>10'</i> , (length) (depth to top)			
<i>4"</i> , <i>Plastic</i> (size) (material)			
(6) pump <i>1/2</i> , <i>10</i> (HP) (yield gpm)			
<i>5hp</i> (type power)			
(7) electric log <i>70</i> (yes or no)			
(organization running log)			
(8) how well bottom plugged <i>Wash Bottom</i>			
DRILLERS REMARKS:			

RECEIVED
 JAN 8 1979

MISS. BD. OF WATER (CLERK)

If well telescopes please sketch and show depths.

GROUND LEVEL

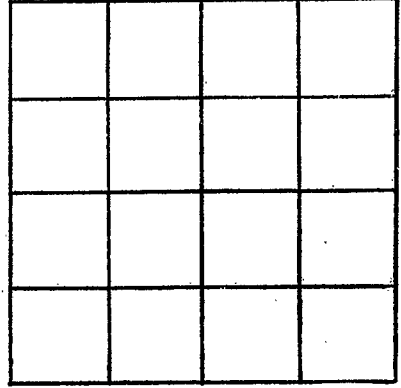

SECTION _____

Please indicate well location X.

ADDITIONAL INFORMATION

If more than one screen, show locations of each on sketch.