

WATER WELL DRILLERS LOG

EA

12-1-64

Date: Dec 1, 1964, Driller: Robert E. Ratliff, County: Lincoln, Miss

(Name)

(1) Owner of Land: Zillatoba Water Ass.
 (Name)
Zillatoba, Miss
 (Address)

(2) Location: 1/4, 1/4, Sec. 25, T. 4 R. 4
3.2 miles, of Zillatoba
 (distance) (direction) (Nearest Town)

(3) Topography: Hilly
 (Hilly) (Flat) (Level)

(4) Purpose of Well: Municipal
 (Domestic Irrigation) (Municipal, Industrial, Other)

Description & Color of Materials Sand, Clay, Red Clay, Shell, etc.	Thick- ness Feet	Depth Feet
<u>Shale & Rocks</u>	<u>954</u>	<u>963</u>
<u>Sand</u>	<u>963</u>	<u>1018</u>
<u>Shale & sand</u>	<u>1018</u>	<u>1039</u>

Information upon completion of well:

(1) Diameter 8 inches.

(2) Total Depth 1039 feet.

(3) Water Level 100 feet below top of ground.

(4) Cased to 1039, Size 8


(5) Screen: Size 4", Length 40'

(6) Were any formations sealed against pollution?
 yes, no.

If YES depth of formation Cemented

Why _____

Drillers Remarks: _____

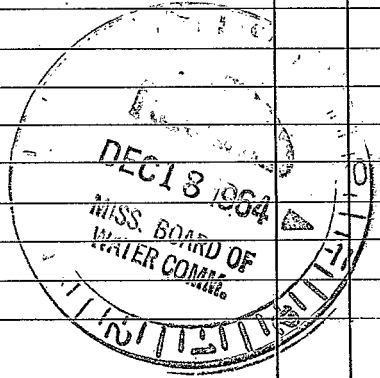

(Use Back Side)

Well No.

(A)

11-2-4

11-2-4
[Faint, illegible handwritten text covering the majority of the page]