

YALO. E7

MISSISSIPPI BOARD OF WATER COMMISSIONERS

2-26-65

WATER WELL DRILLERS LOG

CODED
CODED

Date: 2-26 1965, Driller: J B Cain County Panola
(Name)

(1) Owner of Land:	Description & Color of Materials Sand, Clay, Red Clay, Shell, etc.	Thick- ness Feet	Depth Feet
M. Horis Jackson <small>(Name)</small> Coffeeville Miss <small>(Address)</small>	Brn @ Sand	0 20	20 85
(2) Location: $\frac{1}{4}$, $1\frac{3}{4}$, Sec 25 T 4 R 10 miles E of Coffeeville <small>(distance) (direction) (Nearest Town)</small>			
(3) Topography: <input checked="" type="checkbox"/> (Hilly) <input type="checkbox"/> (Flat) <input type="checkbox"/> (Level)			
(4) Purpose of Well: Home <small>(Domestic Irrigation Municipal, Industrial, Other)</small>			


Information upon completion of well:

- (1) Diameter 2" inches.
- (2) Total Depth 85 feet.
- (3) Water Level 70 feet below top of ground.
- (4) Cased to 85, Size 2"
- (5) Screen: Size 3 Length 5
Shroud Screen
- (6) Were any formations sealed against pollution?
 yes, no.

If YES depth of formation _____

Why _____

Drillers Remarks: _____

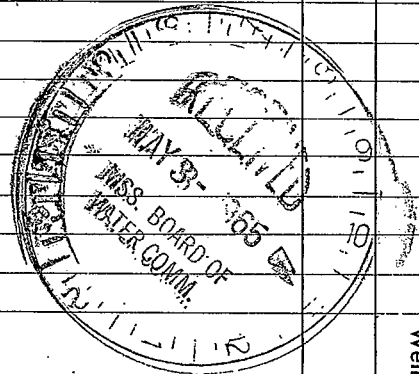

(Use Back Side)

Well No.

