

~~W000~~ E8

2-26-65

WATER WELL DRILLERS LOG

CODED

CODED


Date: 2-26, 1965, Driller: J. B. Cain County Panola
(Name)

(1) Owner of Land	Description & Color of Materials Sand, Clay, Red Clay, Shell, etc.	Thick- ness Feet	Depth Feet
<u>Mr. Horis Jackson</u> (Name) <u>Capeville Miss</u> (Address)	<u>Bro of</u> <u>Sand</u>	<u>0</u>	<u>70</u> <u>20</u> <u>85</u>
(2) Location: <u>1/4</u> , <u>13 1/4</u> , <u>S67</u> , <u>T 7 N</u> <u>6</u> miles (distance) <u>E</u> (direction) of <u>Capeville</u> (Nearest Town)			
(3) Topography: (Hilly) (Flat) (Level)			
(4) Purpose of Well: <u>Home</u> (Domestic Irrigation, Municipal, Industrial, Other)			

Information upon completion of well:

- (1) Diameter 2 inches.
- (2) Total Depth 85 feet.
- (3) Water Level 70 feet below top of ground.
- (4) Cased to 85, Size 2".
- (5) Screen: Size 3 Length 5
Frank Screen
- (6) Were any formations sealed against pollution?
_____ yes, _____ no.

If YES depth of formation _____
Why _____
Drillers Remarks: _____

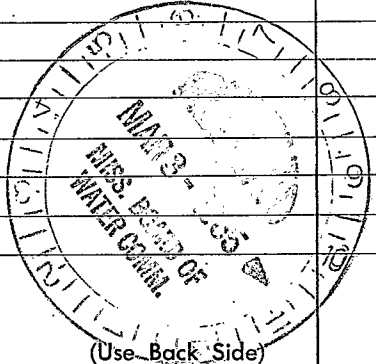

Well No.

