

YALO,  
~~YALO~~  
5-1-65

E 11

MISSISSIPPI BOARD OF WATER COMMISSIONERS

WATER WELL DRILLERS LOG

CODED

CODED

Date: 5-1, 1965, Driller: Gerry Roberson County Panola  
(Name)

(1) Owner of Land: Mrs. Dallas  
(Name)

Copperville, Miss  
(Address)

(2) Location:  $\frac{1}{4}$ ,  $\frac{1}{4}$ , 8 25 4 Sec. T R  
9 miles North of Copperville,  
(distance) (direction) (Nearest Town)

(3) Topography: ✓  
(Hilly) (Flat) (Level)

(4) Purpose of Well: Home  
(Domestic Irrigation  
Municipal, Industrial, Other)

Description & Color of Materials Sand, Clay, Red Clay, Shell, etc.	Thick- ness Feet	Depth Feet
<u>Clay</u>	<u>0</u>	<u>30</u>
<u>Sand</u>	<u>30</u>	<u>60</u>

Information upon completion of well:

(1) Diameter 2 inches.

(2) Total Depth 60 feet.

(3) Water Level 40 feet below top of ground.

(4) Cased to 5-5, Size 2


(5) Screen: Size 3 in, Length 5 ft

(6) Were any formations sealed against pollution?  
 yes,  no.

If YES depth of formation \_\_\_\_\_

Why \_\_\_\_\_

Drillers Remarks: Plastic Well

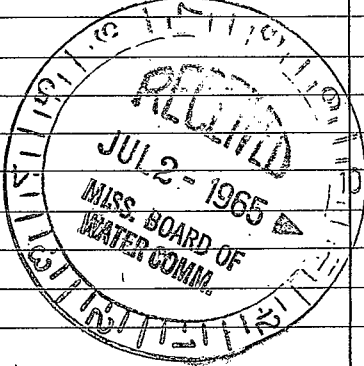

(Use Back Side)

Well No.

